



画地出来形確認測量原図

|       |                        |
|-------|------------------------|
| 業務委託名 | 平成14年度 浜田地区画地出来形確認測量業務 |
|-------|------------------------|

|    |     |
|----|-----|
| 縮尺 | 500 |
|----|-----|

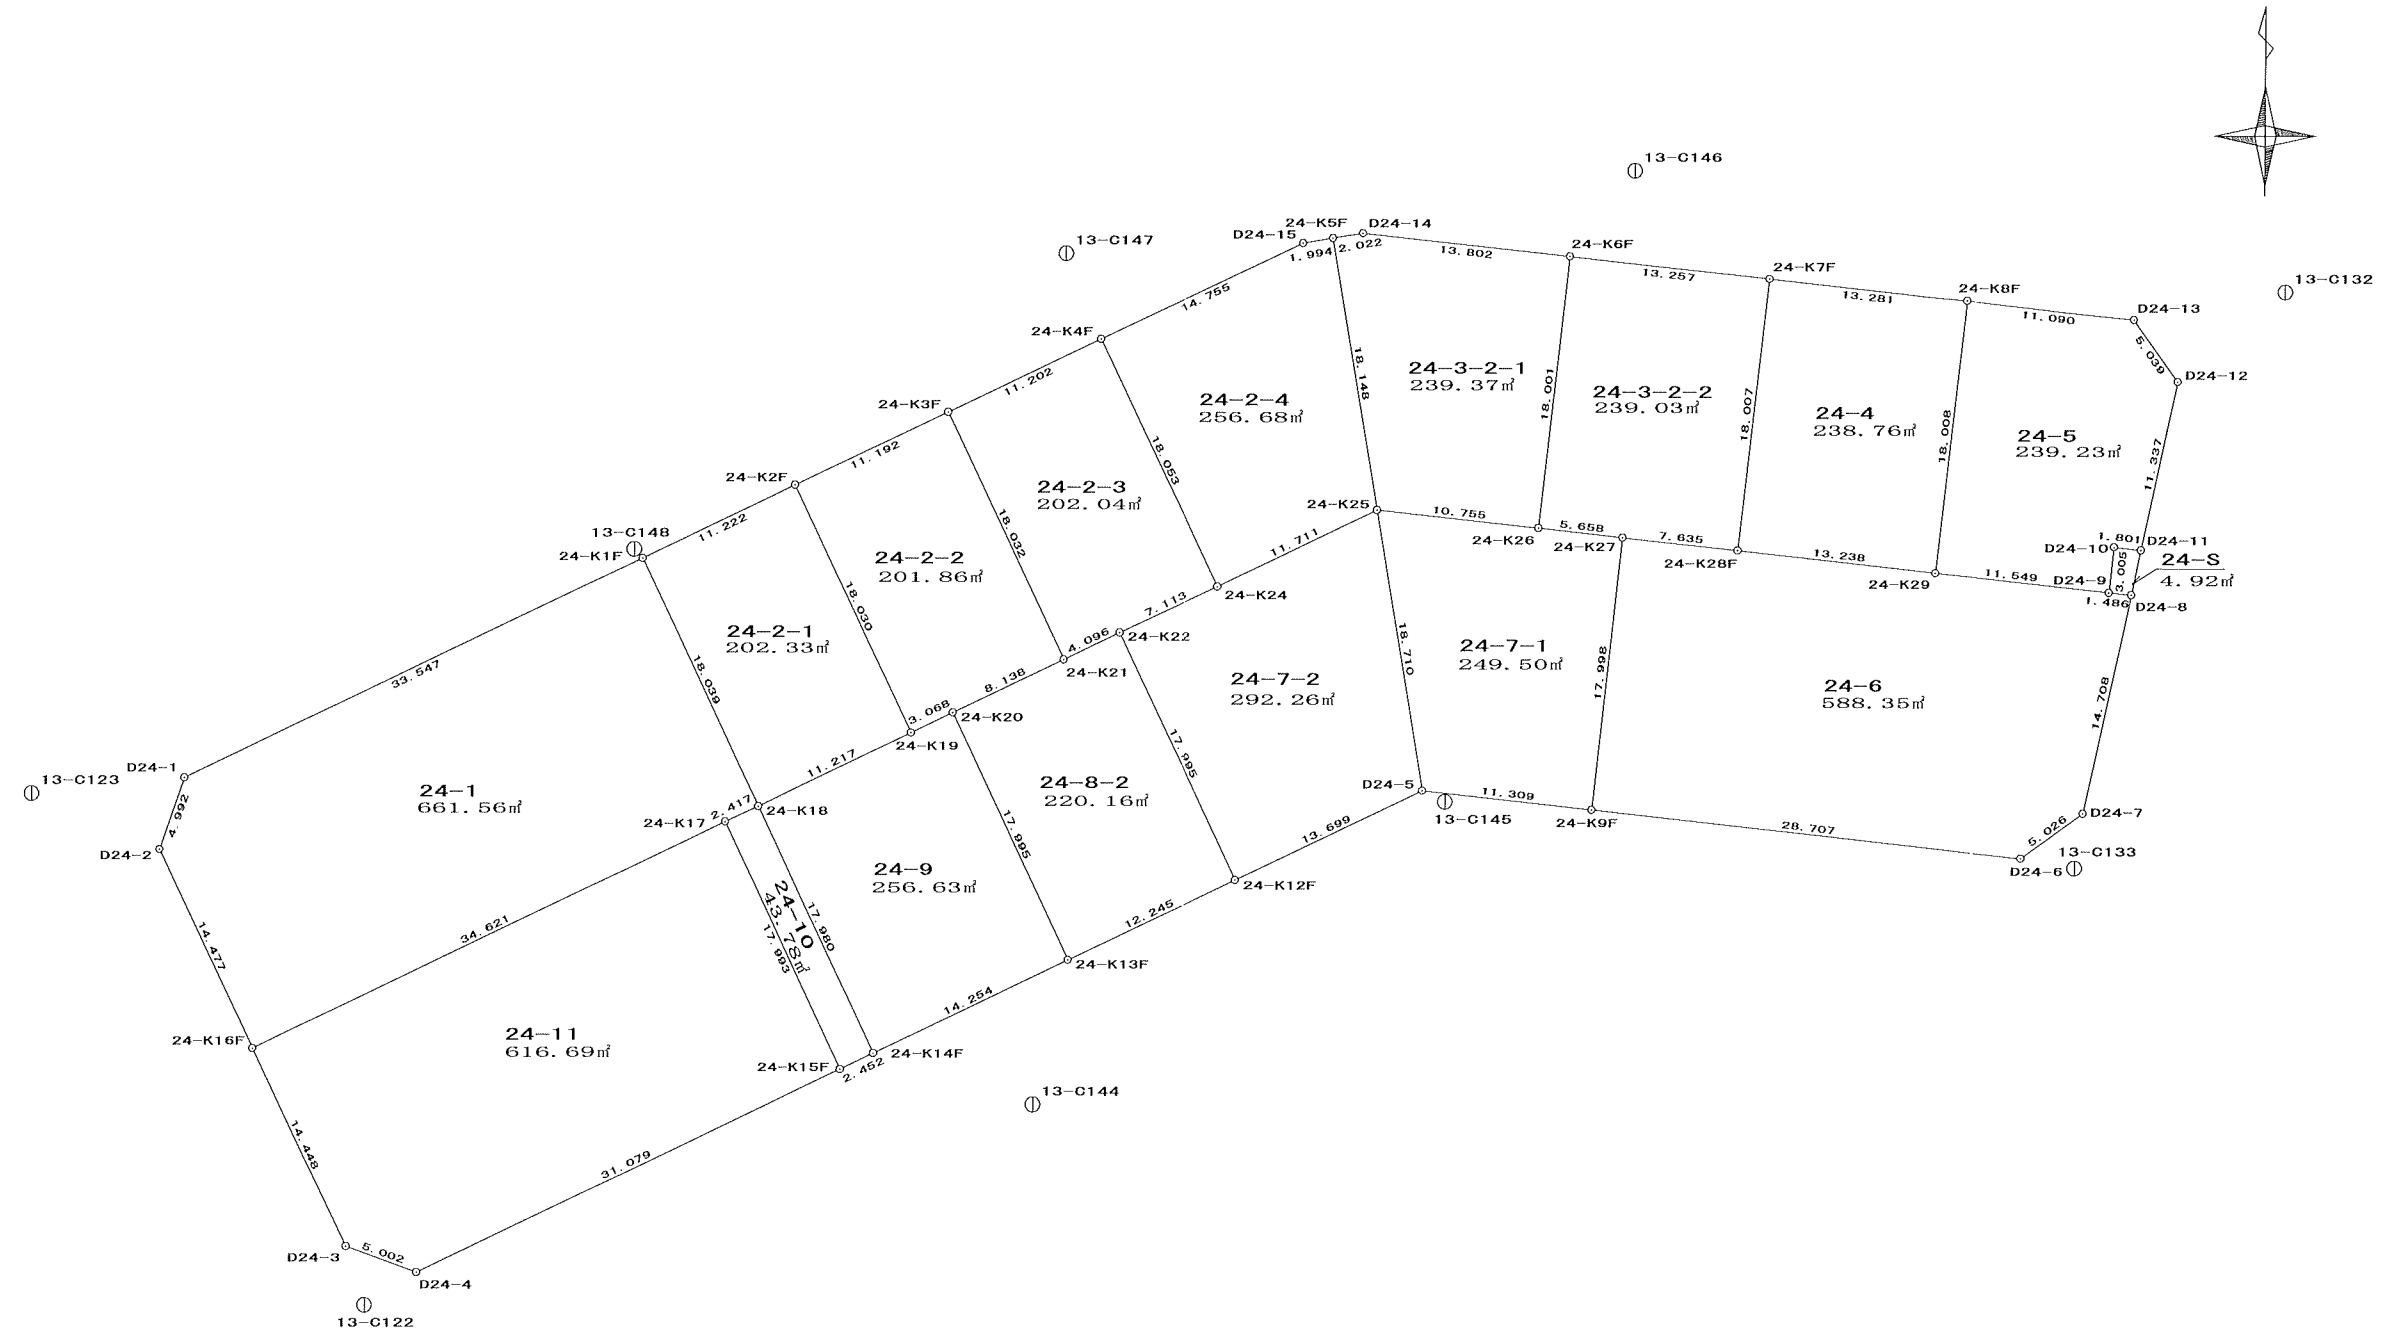

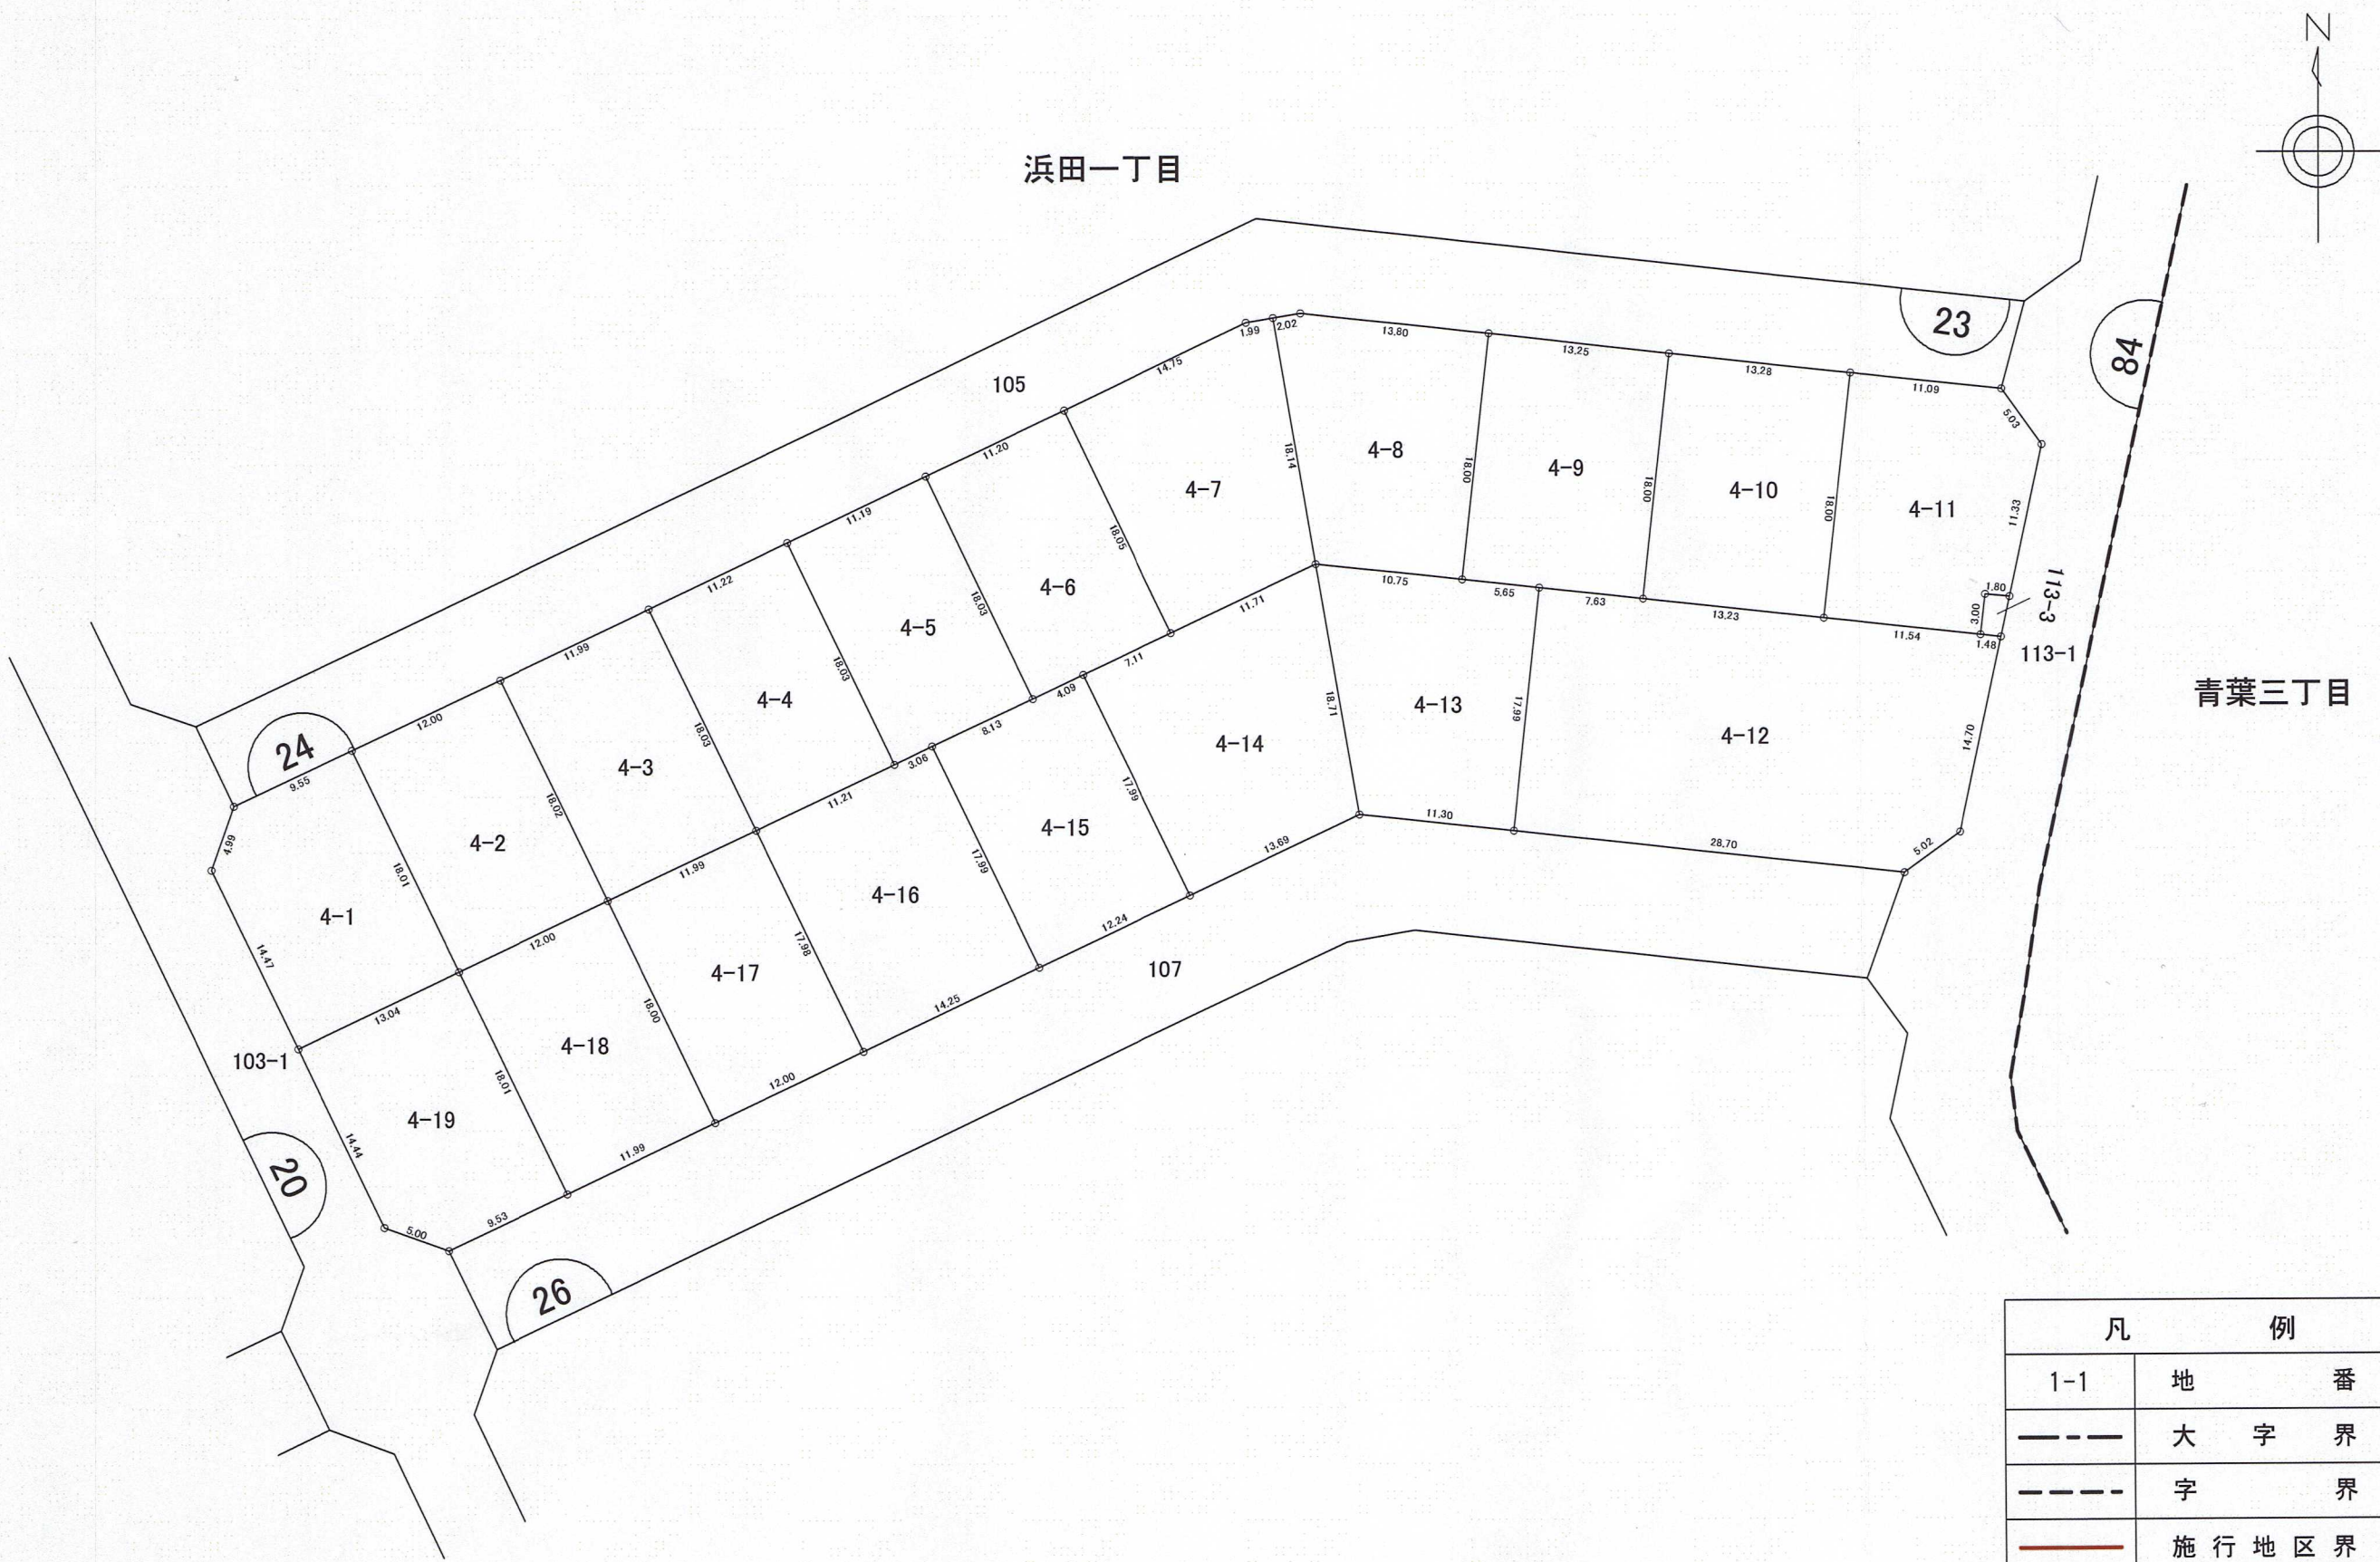

| 凡 例 |           |
|-----|-----------|
| 1-1 | 地 番       |
| --- | 大 字 界     |
| --- | 字 界       |
| —   | 施 行 地 区 界 |
|     | 換 地 の 位 置 |

PAGE : 1

\* \* \* 面積 (座標法) 計算書 \* \* \*

| 测点名     | 夹 角       | 方向角       | 距 離    | [1]       | [2]       | [3]           | [2]*[3]        |
|---------|-----------|-----------|--------|-----------|-----------|---------------|----------------|
|         |           |           |        | X(i)      | Y(i)      | X(i+1)-X(i-1) |                |
| D24-1   | 134-51-22 | 199-22-30 | 4.992  | 89246.169 | -7362.800 | -8.818        | 64925.170400   |
| D24-2   | 135-02-39 | 154-25-09 | 14.477 | 89241.460 | -7364.456 | -17.767       | 130844.289752  |
| 24-K16F | 90-06-00  | 64-31-09  | 13.047 | 89228.402 | -7358.205 | -7.445        | 54781.836225   |
| 24-K32  | 89-59-54  | 334-31-03 | 18.016 | 89234.015 | -7346.427 | 21.876        | -160710.437052 |
| 24-K30F | 90-00-05  | 244-31-08 | 9.551  | 89250.278 | -7354.178 | 12.154        | -89382.679412  |
|         |           |           |        |           |           | 倍面積           | 458.179913     |
|         |           |           |        |           |           | 面 積           | 229.08         |
|         |           |           |        |           |           | 坪 数           | 69.29          |

\* \* \* 面積 (座標法) 計算書 \* \* \*

| 测点名     | 夹 角      | 方向角       | 距 離    | [1]       | [2]       | [3]           | [2]*[3]        |
|---------|----------|-----------|--------|-----------|-----------|---------------|----------------|
|         |          |           |        | X(i)      | Y(i)      | X(i+1)-X(i-1) |                |
| 24-K30F | 89-59-52 | 154-31-03 | 18.016 | 89250.278 | -7354.178 | -21.426       | 157570.617828  |
| 24-K32  | 90-01-48 | 64-32-51  | 12.000 | 89234.015 | -7346.427 | -11.106       | 81589.418262   |
| 24-K33  | 89-58-31 | 334-31-22 | 18.021 | 89239.172 | -7335.592 | 21.426        | -157172.394192 |
| 24-K31F | 89-59-49 | 244-31-11 | 12.001 | 89255.441 | -7343.344 | 11.106        | -81555.178464  |
|         |          |           |        |           |           | 倍面積           | 432.463434     |
|         |          |           |        |           |           | 面 積           | 216.23         |
|         |          |           |        |           |           | 坪 数           | 65.41          |

PAGE : 2

\*\*\* 面積 (座標法) 計算書 \*\*\*

| 测点名     | 夾 角      | 方向角       | 距 離    | [1]       | [2]       | [3]           | [2]*[3]        |
|---------|----------|-----------|--------|-----------|-----------|---------------|----------------|
|         |          |           |        | X(i)      | Y(i)      | X(i+1)-X(i-1) |                |
| 24-K31F | 90-00-09 | 154-31-22 | 18.021 | 89255.441 | -7343.344 | -21.429       | 157360.518576  |
| 24-K33  | 90-04-52 | 64-36-14  | 11.992 | 89239.172 | -7335.592 | -11.126       | 81615.796592   |
| 24-K18  | 89-55-40 | 334-31-54 | 18.039 | 89244.315 | -7324.759 | 21.429        | -156962.260611 |
| 24-K1F  | 89-59-19 | 244-31-13 | 11.995 | 89260.601 | -7332.516 | 11.126        | -81581.573016  |
|         |          |           |        |           |           | 倍面積           | 432.481541     |
|         |          |           |        |           |           | 面 積           | 216.24         |
|         |          |           |        |           |           | 坪 数           | 65.41          |

\* \* \* 面積 (座標法) 計算書 \* \* \*

| 测点名    | 夾 角      | 方向角       | 距 離    | [1]<br>X(i) | [2]<br>Y(i) | [3]<br>X(i+1)-X(i-1) | [2]*[3]        |
|--------|----------|-----------|--------|-------------|-------------|----------------------|----------------|
| 24-K2F | 89-58-15 | 244-31-02 | 11.222 | 89265.429   | -7322.386   | 11.452               | -83855.964472  |
| 24-K1F | 90-00-52 | 154-31-54 | 18.039 | 89260.601   | -7332.516   | -21.114              | 154818.742824  |
| 24-K18 | 89-56-26 | 64-28-20  | 11.217 | 89244.315   | -7324.759   | -11.452              | 83883.140068   |
| 24-K19 | 90-04-27 | 334-32-47 | 18.030 | 89249.149   | -7314.637   | 21.114               | -154441.245618 |
|        |          |           |        |             |             | 倍面積                  | 404.672802     |
|        |          |           |        |             |             | 面 積                  | 202.33         |
|        |          |           |        |             |             | 坪 数                  | 61.20          |

PAGE : 3

**\* \* \* 面積 (座標法) 計算書 \* \* \***

| 測点名    | 夾 角       | 方向角       | 距 離    | [1]       | [2]       | [3]           | [2]*[3]        |
|--------|-----------|-----------|--------|-----------|-----------|---------------|----------------|
|        |           |           |        | X(i)      | Y(i)      | X(i+1)-X(i-1) |                |
| 24-K3F | 90-01-16  | 244-31-29 | 11.192 | 89270.243 | -7312.282 | 11.462        | -83813.376284  |
| 24-K2F | 90-01-18  | 154-32-47 | 18.030 | 89265.429 | -7322.386 | -21.094       | 154458.410284  |
| 24-K19 | 89-46-56  | 64-19-43  | 3.068  | 89249.149 | -7314.637 | -14.951       | 109361.137787  |
| 24-K20 | 180-17-02 | 64-36-45  | 8.138  | 89250.478 | -7311.872 | 4.818         | -35228.599296  |
| 24-K21 | 89-53-28  | 334-30-13 | 18.032 | 89253.967 | -7304.520 | 19.765        | -144373.837800 |
|        |           |           |        |           |           | 倍面積           | 403.734691     |
|        |           |           |        |           |           | 面 積           | 201.86         |
|        |           |           |        |           |           | 坪 數           | 61.06          |

\* \* \* 面積 (座標法) 計算書 \* \* \*

[illegible]

PAGE : 4

\* \* \* 面積（座標法）計算書 \* \* \*

[illegible]

\* \* \* 面積 (座標法) 計算書 \* \* \*

| 測点名    | 夾 角       | 方向角       | 距 離    | [1]       | [2]       | [3]           | [2]*[3]        |
|--------|-----------|-----------|--------|-----------|-----------|---------------|----------------|
|        |           |           |        | X(i)      | Y(i)      | X(i+1)-X(i-1) |                |
| 24-K5F | 89-47-21  | 170-20-27 | 18.148 | 89281.738 | -7286.883 | -18.223       | 132788.868909  |
| 24-K25 | 105-53-39 | 96-14-06  | 10.755 | 89263.847 | -7283.838 | -19.059       | 138822.668442  |
| 24-K26 | 90-04-36  | 6-18-42   | 18.001 | 89262.679 | -7273.147 | 16.724        | -121636.110428 |
| 24-K6F | 89-55-25  | 276-14-07 | 13.802 | 89280.571 | -7271.168 | 19.391        | -140995.218688 |
| D24-14 | 164-18-59 | 260-33-06 | 2.022  | 89282.070 | -7284.888 | 1.167         | -8501.464296   |
|        |           |           |        |           |           | 倍面積           | 478.743939     |
|        |           |           |        |           |           | 面 積           | 239.37         |
|        |           |           |        |           |           | 坪 數           | 72.41          |

PAGE : 5

\*\*\* 面積 (座標法) 計算書 \*\*\*

| 测点名     | 夾 角       | 方向角       | 距 離    | [1]       | [2]       | [3]           | [2]*[3]        |
|---------|-----------|-----------|--------|-----------|-----------|---------------|----------------|
|         |           |           |        | X(i)      | Y(i)      | X(i+1)-X(i-1) |                |
| 24-K6F  | 90-04-16  | 186-18-42 | 18.001 | 89280.571 | -7271.168 | -16.451       | 119617.984768  |
| 24-K26  | 89-59-58  | 96-18-40  | 5.658  | 89262.679 | -7273.147 | -18.514       | 134655.043558  |
| 24-K27  | 179-55-20 | 96-14-00  | 7.635  | 89262.057 | -7267.523 | -1.451        | 10545.175873   |
| 24-K28F | 89-57-40  | 6-11-40   | 18.007 | 89261.228 | -7259.933 | 17.073        | -123948.836109 |
| 24-K7F  | 90-02-46  | 276-14-26 | 13.257 | 89279.130 | -7257.990 | 19.343        | -140391.300570 |
|         |           |           |        |           |           | 倍面積           | 478.067520     |
|         |           |           |        |           |           | 面 積           | 239.03         |
|         |           |           |        |           |           | 坪 数           | 72.30          |

\* \* \* 面積 (座標法) 計算書 \* \* \*

| 测点名     | 夾 角      | 方向角       | 距 離    | [1]       | [2]       | [3]           | [2]*[3]        |
|---------|----------|-----------|--------|-----------|-----------|---------------|----------------|
|         |          |           |        | X(i)      | Y(i)      | X(i+1)-X(i-1) |                |
| 24-K7F  | 89-57-40 | 186-11-40 | 18.007 | 89279.130 | -7257.990 | -16.460       | 119466.515400  |
| 24-K28F | 90-02-30 | 96-14-10  | 13.238 | 89261.228 | -7259.933 | -19.340       | 140407.104220  |
| 24-K29  | 90-05-33 | 6-19-43   | 18.008 | 89259.790 | -7246.773 | 16.460        | -119281.883580 |
| 24-K8F  | 89-54-17 | 276-14-00 | 13.281 | 89277.688 | -7244.788 | 19.340        | -140114.199920 |
|         |          |           |        |           |           | 倍面積           | 477.536120     |
|         |          |           |        |           |           | 面 積           | 238.76         |
|         |          |           |        |           |           | 坪 数           | 72.22          |

PAGE : 6

\* \* \* 面積 (座標法) 計算書 \* \* \*

[illegible]

PAGE : 7

\*\*\* 面積 (座標法) 計算書 \*\*\*

[illegible]

\*\*\* 面積（座標法）計算書 \*\*\*

[illegible]

PAGE : 8

\* \* \* 面積 (座標法) 計算書 \* \* \*

| 测点名     | 夾 角       | 方向角       | 距 離    | [1]<br>X(i) | [2]<br>Y(i) | [3]<br>X(i+1)-X(i-1) | [2]*[3]        |
|---------|-----------|-----------|--------|-------------|-------------|----------------------|----------------|
| 24-K25  | 73-55-00  | 244-18-52 | 11.711 | 89263.847   | -7283.838   | 13.372               | -97399.481736  |
| 24-K24  | 180-30-01 | 244-48-53 | 7.113  | 89258.771   | -7294.392   | -8.103               | 59106.458376   |
| 24-K22  | 89-41-07  | 154-30-00 | 17.995 | 89255.744   | -7300.829   | -19.269              | 140679.674001  |
| 24-K12F | 90-00-11  | 64-30-11  | 13.699 | 89239.502   | -7293.082   | -10.345              | 75446.933290   |
| D24-5   | 105-53-41 | 350-23-52 | 18.710 | 89245.399   | -7280.717   | 24.345               | -177249.055365 |
|         |           |           |        |             |             | 倍面積                  | 584.528566     |
|         |           |           |        |             |             | 面 積                  | 292.26         |
|         |           |           |        |             |             | 坪 數                  | 88.40          |

\* \* \* 面積 (座標法) 計算書 \* \* \*

| 测点名     | 夹 角       | 方向角       | 距 離    | [1]       | [2]       | [3]           | [2]*[3]        |
|---------|-----------|-----------|--------|-----------|-----------|---------------|----------------|
|         |           |           |        | X(i)      | Y(i)      | X(i+1)-X(i-1) |                |
| 24-K22  | 89-47-31  | 244-17-31 | 4.096  | 89255.744 | -7300.829 | 14.465        | -105606.491485 |
| 24-K21  | 180-19-14 | 244-36-45 | 8.138  | 89253.967 | -7304.520 | -5.266        | 38465.602320   |
| 24-K20  | 89-55-24  | 154-32-09 | 17.995 | 89250.478 | -7311.872 | -19.736       | 144307.105792  |
| 24-K13F | 89-58-06  | 64-30-15  | 12.245 | 89234.231 | -7304.135 | -10.976       | 80170.185760   |
| 24-K12F | 89-59-45  | 334-30-00 | 17.995 | 89239.502 | -7293.082 | 21.513        | -156896.073066 |
|         |           |           |        |           |           | 倍面積           | 440.329321     |
|         |           |           |        |           |           | 面 積           | 220.16         |
|         |           |           |        |           |           | 坪 数           | 66.59          |

PAGE : 9

\* \* \* 面積 (座標法) 計算書 \* \* \*

[illegible]

\* \* \* 面積 (座標法) 計算書 \* \* \*

| 测点名     | 夹 角      | 方向角       | 距 離    | [1]<br>X(i) | [2]<br>Y(i) | [3]<br>X(i+1)-X(i-1) | [2]*[3]        |
|---------|----------|-----------|--------|-------------|-------------|----------------------|----------------|
| 24-K18  | 90-09-56 | 244-36-14 | 11.992 | 89244.315   | -7324.759   | 11.077               | -81136.355443  |
| 24-K33  | 89-52-08 | 154-28-22 | 18.000 | 89239.172   | -7335.592   | -21.386              | 156878.970512  |
| 24-K35F | 90-02-02 | 64-30-24  | 12.003 | 89222.929   | -7327.835   | -11.077              | 81170.428295   |
| 24-K14F | 89-55-54 | 334-26-18 | 17.980 | 89228.095   | -7317.001   | 21.386               | -156481.383386 |
|         |          |           |        |             |             | 倍面積                  | 431.659978     |
|         |          |           |        |             |             | 面 積                  | 215.82         |
|         |          |           |        |             |             | 坪 数                  | 65.28          |

PAGE : 10

\*\*\* 面積 (座標法) 計算書 \*\*\*

[illegible]

\*\*\* 面積（座標法）計算書 \*\*\*

| 測点名     | 夾 角       | 方向角       | 距 離    | [1]       | [2]       | [3]           | [2]*[3]        |
|---------|-----------|-----------|--------|-----------|-----------|---------------|----------------|
|         |           |           |        | X(i)      | Y(i)      | X(i+1)-X(i-1) |                |
| 24-K32  | 90-03-10  | 244-31-09 | 13.047 | 89234.015 | -7346.427 | 10.638        | -78151.290426  |
| 24-K16F | 89-54-07  | 154-25-16 | 14.448 | 89228.402 | -7358.205 | -18.645       | 137193.732225  |
| D24-3   | 135-32-47 | 109-58-03 | 5.002  | 89215.370 | -7351.967 | -14.740       | 108367.993580  |
| D24-4   | 134-32-15 | 64-30-18  | 9.530  | 89213.662 | -7347.266 | 2.394         | -17589.354804  |
| 24-K34F | 89-57-41  | 334-27-59 | 18.010 | 89217.764 | -7338.664 | 20.353        | -149363.828392 |
|         |           |           |        |           |           | 倍面積           | 457.252183     |
|         |           |           |        |           |           | 面 積           | 228.62         |
|         |           |           |        |           |           | 坪 數           | 69.15          |