

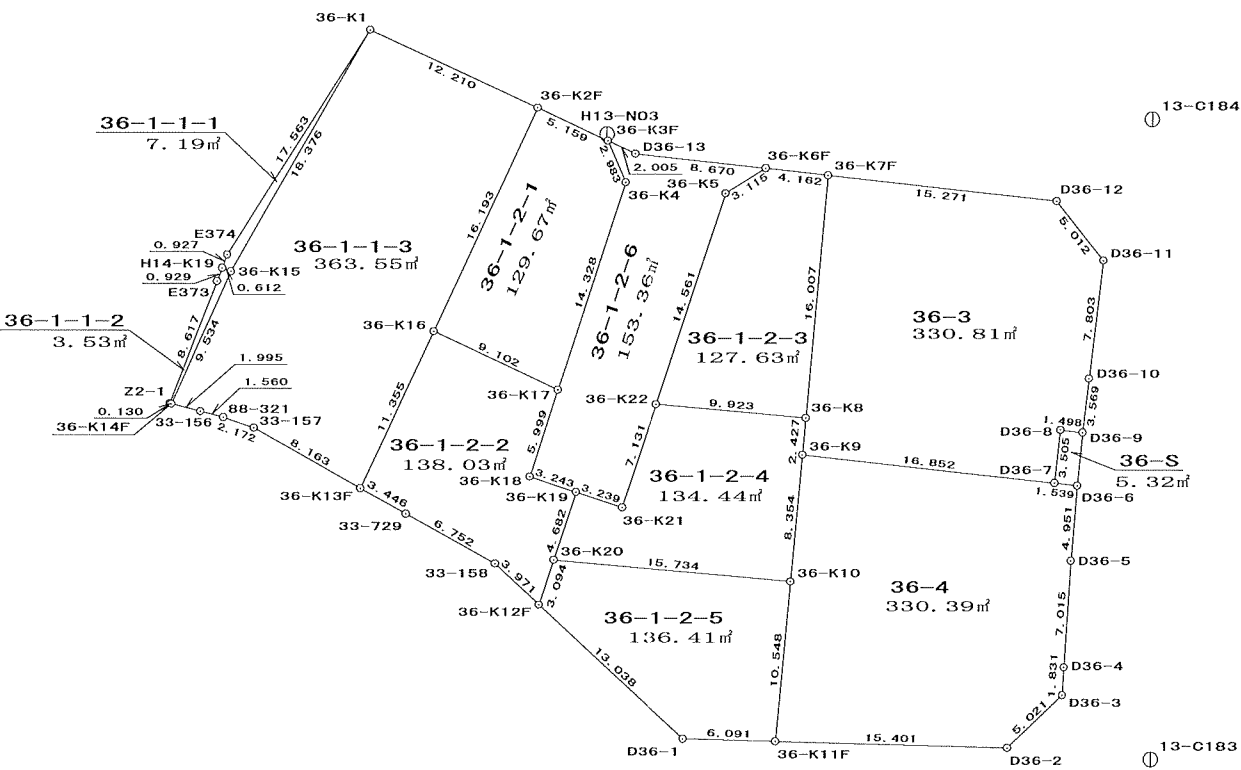


画地出来形確認測量原図

業務委託名	平成14年度 浜田地区画地出来形確認測量業務
-------	------------------------

縮尺	500
----	-----

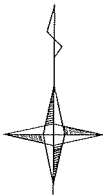

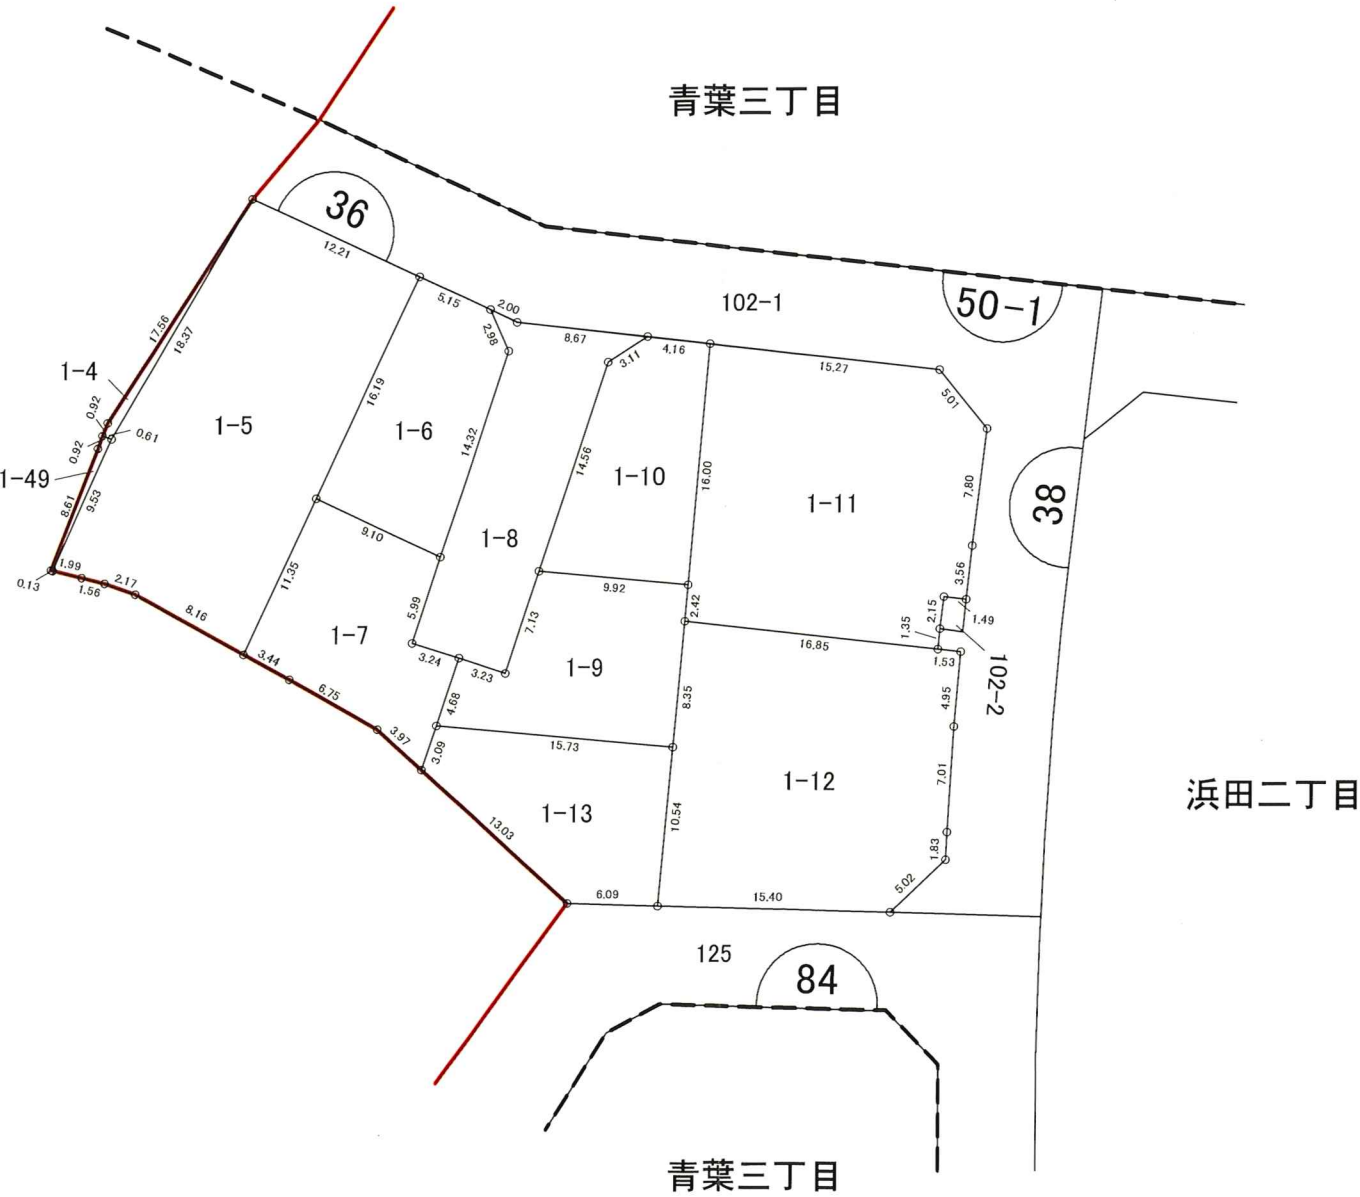

凡 例	
1-1	地 番
---	大 字 界
----	字 界
—	施行地区界
□	換地の位置

PAGE : 1

* * * 面積 (座標法) 計算書 * * *

[illegible]

* * * 面積（座標法）計算書 * * *

[illegible]

PAGE : 2

* * * 面積 (座標法) 計算書 * * *

[illegible]

* * * 面積 (座標法) 計算書 * * *

[illegible]

PAGE : 3

*** * * 面積 (座標法) 計算書 * * ***

[illegible]

*** * * 面積 (座標法) 計算書 * * ***

测点名	夾 角	方向角	距 離	[1]	[2]	[3]	[2]*[3]
				X(i)	Y(i)	X(i+1)-X(i-1)	
36-K6F	141-29-52	237-46-27	3.115	89272.344	-6807.995	-1.206	8210.441970
36-K5	140-12-55	197-59-22	14.561	89270.683	-6810.630	-15.510	105632.871300
36-K22	77-10-04	95-09-26	9.923	89256.834	-6815.127	-14.741	100461.787107
36-K8	89-48-36	4-58-02	16.007	89255.942	-6805.244	15.055	-102452.948420
36-K7F	91-18-33	276-16-35	4.162	89271.889	-6803.858	16.402	-111596.878916
						倍面積	255.273041
						面 積	127.63
						坪 数	38.61

PAGE : 4

* * * 面積 (座標法) 計算書 * * *

测点名	夾 角	方向角	距 離	[1]	[2]	[3]	[2]*[3]
				X(i)	Y(i)	X(i+1)-X(i-1)	
36-K8	90-14-26	275-09-26	9.923	89255.942	-6805.244	3.310	-22525.357640
36-K22	102-51-12	198-00-38	7.131	89256.834	-6815.127	-5.890	40141.098030
36-K21	269-56-16	287-56-54	3.239	89250.052	-6817.332	-5.784	39431.448288
36-K19	90-08-32	198-05-26	4.682	89251.050	-6820.413	-3.453	23550.886089
36-K20	76-59-59	95-05-25	15.734	89246.599	-6821.867	-5.847	39887.456349
36-K10	90-00-44	5-06-09	8.354	89245.203	-6806.195	6.925	-47132.900375
36-K9	179-48-51	4-55-00	2.427	89253.524	-6805.452	10.739	-73083.749028
						倍面積	268.881713
						面 積	134.44
						坪 數	40.66

* * * 面積 (座標法) 計算書 * * *

测点名	夾角	方向角	距離	[1] X(i)	[2] Y(i)	[3] X(i+1)-X(i-1)	[2]*[3]
36-K10	90-02-15	275-05-25	15.734	89245.203	-6806.195	11.903	-81014.139085
36-K20	103-03-49	198-09-14	3.094	89246.599	-6821.867	-1.544	10532.962648
36-K12F	114-18-35	132-27-49	13.038	89243.659	-6822.831	-11.742	80113.681602
D36-1	139-03-04	91-30-53	6.091	89234.857	-6813.213	-8.963	61066.828119
36-K11F	93-32-17	5-03-10	10.548	89234.696	-6807.124	10.346	-70426.504904
						倍面積	272.828380
						面 積	136.41
						坪 数	41.26

PAGE : 5

* * * 面積 (座標法) 計算書 * * *

测点名	夾 角	方向角	距 離	[1]	[2]	[3]	[2]*[3]
				X(i)	Y(i)	X(i+1)-X(i-1)	
36-K3F	41-33-50	156-21-54	2.983	89274.135	-6818.433	-1.892	12900.475236
36-K4	221-34-09	197-56-03	14.328	89271.402	-6817.237	-16.365	111564.083505
36-K17	179-58-42	197-54-45	5.999	89257.770	-6821.649	-19.340	131930.691660
36-K18	90-16-16	108-11-01	3.243	89252.062	-6823.494	-6.720	45853.879680
36-K19	179-45-53	107-56-54	3.239	89251.050	-6820.413	-2.010	13709.030130
36-K21	90-03-44	18-00-38	7.131	89250.052	-6817.332	5.784	-39431.448288
36-K22	179-58-44	17-59-22	14.561	89256.834	-6815.127	20.631	-140602.885137
36-K5	219-47-05	57-46-27	3.115	89270.683	-6810.630	15.510	-105632.871300
36-K6F	38-30-59	276-17-26	8.670	89272.344	-6807.995	2.611	-17775.674945
D36-13	198-30-38	294-48-04	2.005	89273.294	-6816.613	1.791	-12208.553883
						倍面積	306.726658
						面 積	153.36
						坪 数	46.39

PAGE : 6

*** 面積 (座標法) 計算書 ***

[illegible]

PAGE : 7

*** 面積 (座標法) 計算書 ***

測点名	夾 角	方向角	距 離	[1]	[2]	[3]	[2]*[3]
				X(i)	Y(i)	X(i+1)-X(i-1)	
36-K9	88-52-18	185-06-09	8.354	89253.524	-6805.452	-6.492	44180.994384
36-K10	179-57-01	185-03-10	10.548	89245.203	-6806.195	-18.828	128147.039460
36-K11F	86-27-55	91-31-05	15.401	89234.696	-6807.124	-10.915	74299.758460
D36-2	134-45-54	46-16-59	5.021	89234.288	-6791.728	3.062	-20796.271136
D36-3	137-04-01	3-21-00	1.831	89237.758	-6788.099	5.298	-35963.348502
D36-4	180-09-22	3-30-22	7.015	89239.586	-6787.992	8.830	-59937.969360
D36-5	181-02-08	4-32-30	4.951	89246.588	-6787.563	11.937	-81023.139531
D36-6	91-52-36	276-25-06	1.539	89251.523	-6787.171	5.107	-34662.082297
D36-7	179-48-45	276-13-51	16.852	89251.695	-6788.700	2.001	-13584.188700
						倍面積	660.792778
						面 積	330.39
						坪 數	99.94