

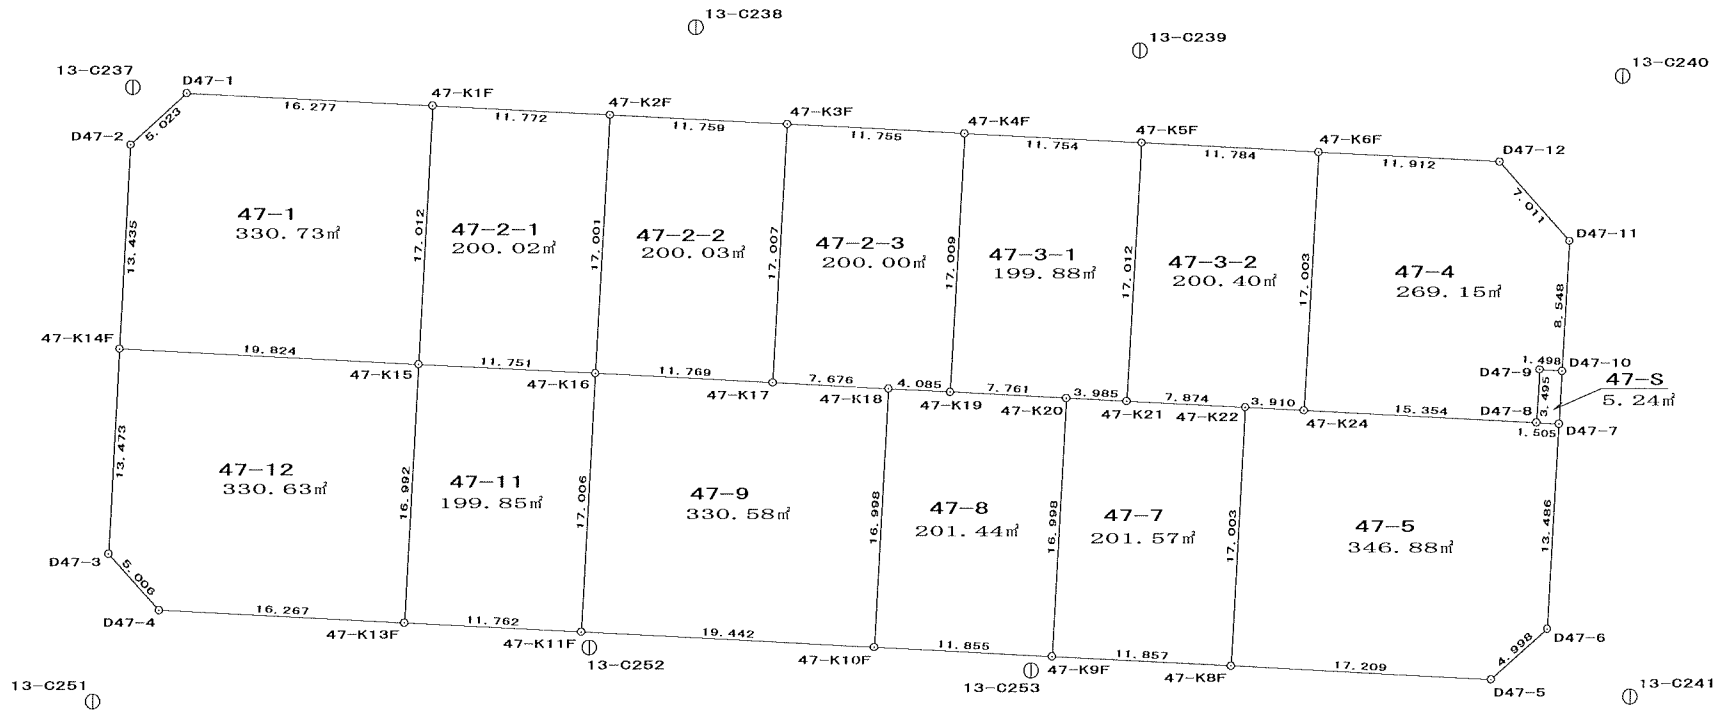


画地出来形確認測量原図

業務委託名	平成14年度 浜田地区画地出来形確認測量業務
-------	------------------------

縮尺	500
----	-----

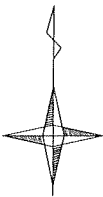

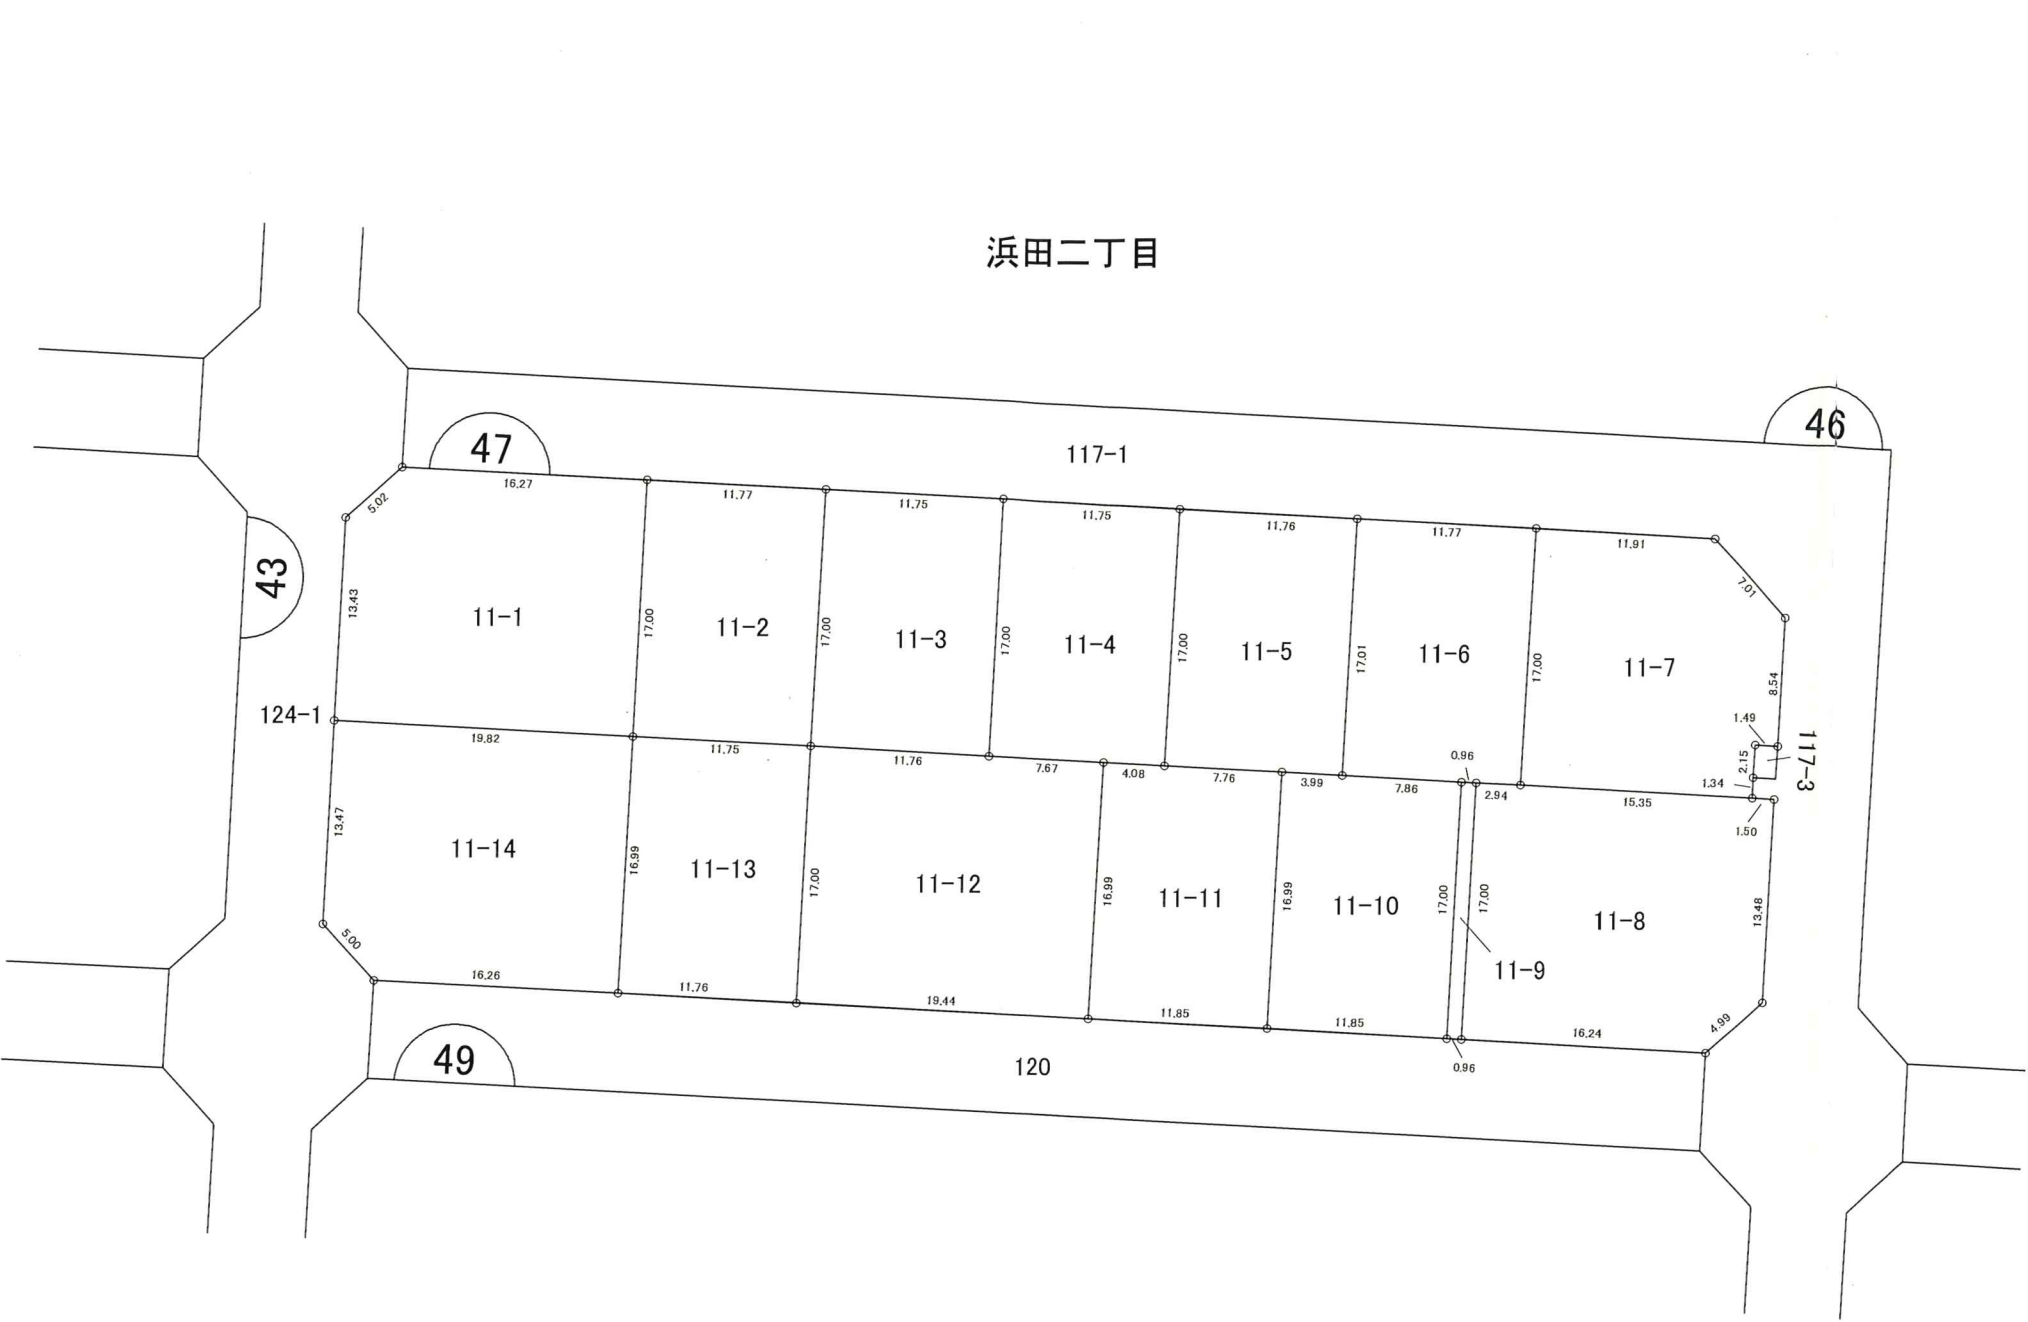

凡 例	
1-1	地 番
---	大 字 界
----	字 界
—	施 行 地 区 界
□	換 地 の 位 置

PAGE : 1

* * * 面積 (座標法) 計算書 * * *

[illegible]

* * * 面積 (座標法) 計算書 * * *

[illegible]

PAGE : 2

* * * 面積（座標法）計算書 * * *

测点名	夾 角	方向角	距 離	[1] X(i)	[2] Y(i)	[3] X(i+1)-X(i-1)	[2]*[3]
47-K3F	89-58-39	272-55-11	11.759	88953.152	-6815.602	17.584	-119845.545568
47-K2F	90-02-26	182-57-37	17.001	88953.751	-6827.346	-16.379	111825.100134
47-K16	89-59-32	92-57-09	11.765	88936.773	-6828.224	-17.584	120067.490816
47-K17	89-59-23	2-56-32	17.007	88936.167	-6816.475	16.379	-111647.044025
						倍面積	400.001357
						面 積	200.00
						坪 數	60.50

* * * 面積 (座標法) 計算書 * * *

测点名	夾 角	方向角	距 離	[1] X(i)	[2] Y(i)	[3] X(i+1)-X(i-1)	[2]*[3]
47-K4F	90-00-50	272-56-08	11.755	88952.550	-6803.862	17.589	-119673.128718
47-K3F	90-00-24	182-56-32	17.007	88953.152	-6815.602	-16.383	111660.007566
47-K17	90-01-20	92-57-52	7.676	88936.167	-6816.475	-17.382	118483.968450
47-K18	179-56-24	92-54-16	4.085	88935.770	-6808.809	-0.604	4112.520636
47-K19	90-01-02	2-55-18	17.009	88935.563	-6804.729	16.780	-114183.352620
						倍面積	400.015314
						面 積	200.00
						坪 数	60.50

PAGE : 3

*** 面積 (座標法) 計算書 ***

测点名	夹 角	方向角	距 离	[1]	[2]	[3]	[2]*[3]
				X(i)	Y(i)	X(i+1)-X(i-1)	
47-K5F	89-59-25	272-56-19	11.762	88951.947	-6792.115	17.592	-119486.887080
47-K4F	89-58-59	182-55-18	17.009	88952.550	-6803.862	-16.384	111474.475008
47-K19	90-01-57	92-57-15	7.761	88935.563	-6804.729	-17.387	118313.823123
47-K20	179-59-19	92-56-34	3.993	88935.163	-6796.978	-0.605	4112.171690
47-K21	90-00-20	2-56-54	17.012	88934.958	-6792.990	16.784	-114013.544160
						倍面積	400.038581
						面 積	200.01
						坪 数	60.50

* * * 面積 (座標法) 計算書 * * *

[illegible]

PAGE : 4

* * * 面積 (座標法) 計算書 * * *

测点名	夹 角	方向角	距 离	[1]	[2]	[3]	[2]*[3]
				X(i)	Y(i)	X(i+1)-X(i-1)	
47-K6F	90-00-52	182-57-00	17.003	88951.343	-6780.354	-16.370	110994.394980
47-K24	89-57-03	92-54-03	15.354	88934.363	-6781.229	-17.757	120414.283353
D47-8	90-18-27	3-12-30	1.340	88933.586	-6765.895	0.561	-3795.667095
D47-14	179-59-00	3-11-30	2.155	88934.924	-6765.820	3.490	-23612.711800
D47-9	270-10-37	93-22-07	1.498	88937.076	-6765.700	2.064	-13964.404800
D47-10	89-35-19	2-57-26	8.548	88936.988	-6764.205	8.449	-57150.768045
D47-11	135-00-51	317-58-17	7.011	88945.525	-6763.764	13.745	-92967.936180
D47-12	134-57-51	272-56-08	11.912	88950.733	-6768.458	5.818	-39378.888644
						倍面積	538.301769
						面 積	269.15
						坪 数	81.41

PAGE : 5

* * * 面積 (座標法) 計算書 * * *

测点名	夾 角	方向角	距 離	[1]	[2]	[3]	[2]*[3]
				X(i)	Y(i)	X(i+1)-X(i-1)	
47-K24	180-03-17	272-57-20	2.948	88934.363	-6781.229	0.929	-6299.761741
47-K23	89-55-59	182-53-19	17.006	88934.515	-6784.173	-16.832	114191.199936
47-K7F	90-02-37	92-55-56	16.245	88917.531	-6785.030	-17.815	120875.309450
D47-5	135-14-21	48-10-17	4.998	88916.700	-6768.806	2.502	-16935.552612
D47-6	134-45-41	2-55-58	13.486	88920.033	-6765.082	16.801	-113660.142682
D47-7	90-18-15	273-14-13	1.505	88933.501	-6764.392	13.553	-91677.804776
D47-8	179-39-50	272-54-03	15.354	88933.586	-6765.895	0.862	-5832.201490
						倍面積	661.046085
						面 積	330.52
						坪 数	99.98

* * * 面積 (座標法) 計算書 * * *

[illegible]

PAGE : 6

* * * 面積 (座標法) 計算書 * * *

[illegible]

* * * 面積 (座標法) 計算書 * * *

测点名	夹 角	方向角	距 離	[1]	[2]	[3]	[2]*[3]
				X(i)	Y(i)	X(i+1)-X(i-1)	
47-K20	90-04-03	272-57-15	7.761	88935.163	-6796.978	17.376	-118104.289728
47-K19	179-57-01	272-54-16	4.085	88935.563	-6804.729	0.607	-4130.470503
47-K18	90-00-33	182-54-49	16.998	88935.770	-6808.809	-16.769	114176.918121
47-K10F	90-01-17	92-56-06	11.855	88918.794	-6809.673	-17.583	119734.480359
47-K9F	89-57-06	2-53-12	16.998	88918.187	-6797.834	16.369	-111273.744746
						倍面積	402.893503
						面 積	201.44
						坪 数	60.93

PAGE : 7

*** 面積 (座標法) 計算書 ***

[illegible]

* * * 面積 (座標法) 計算書 * * *

测点名	夹 角	方向角	距 離	[1]	[2]	[3]	[2]*[3]
				X(i)	Y(i)	X(i+1)-X(i-1)	
47-K16	89-58-36	272-53-44	11.759	88936.773	-6828.224	17.578	-120026.521472
47-K15	90-03-06	182-56-50	16.998	88937.367	-6839.968	-16.382	112052.355776
47-K13F	89-59-07	92-55-57	11.767	88920.391	-6840.842	-17.578	120248.320676
47-K11F	89-59-11	2-55-08	17.006	88919.789	-6829.090	16.382	-111874.152380
						倍面積	400.002600
						面 積	200.00
						坪 数	60.50

PAGE : 8

* * * 面積 (座標法) 計算書 * * *

[illegible]