

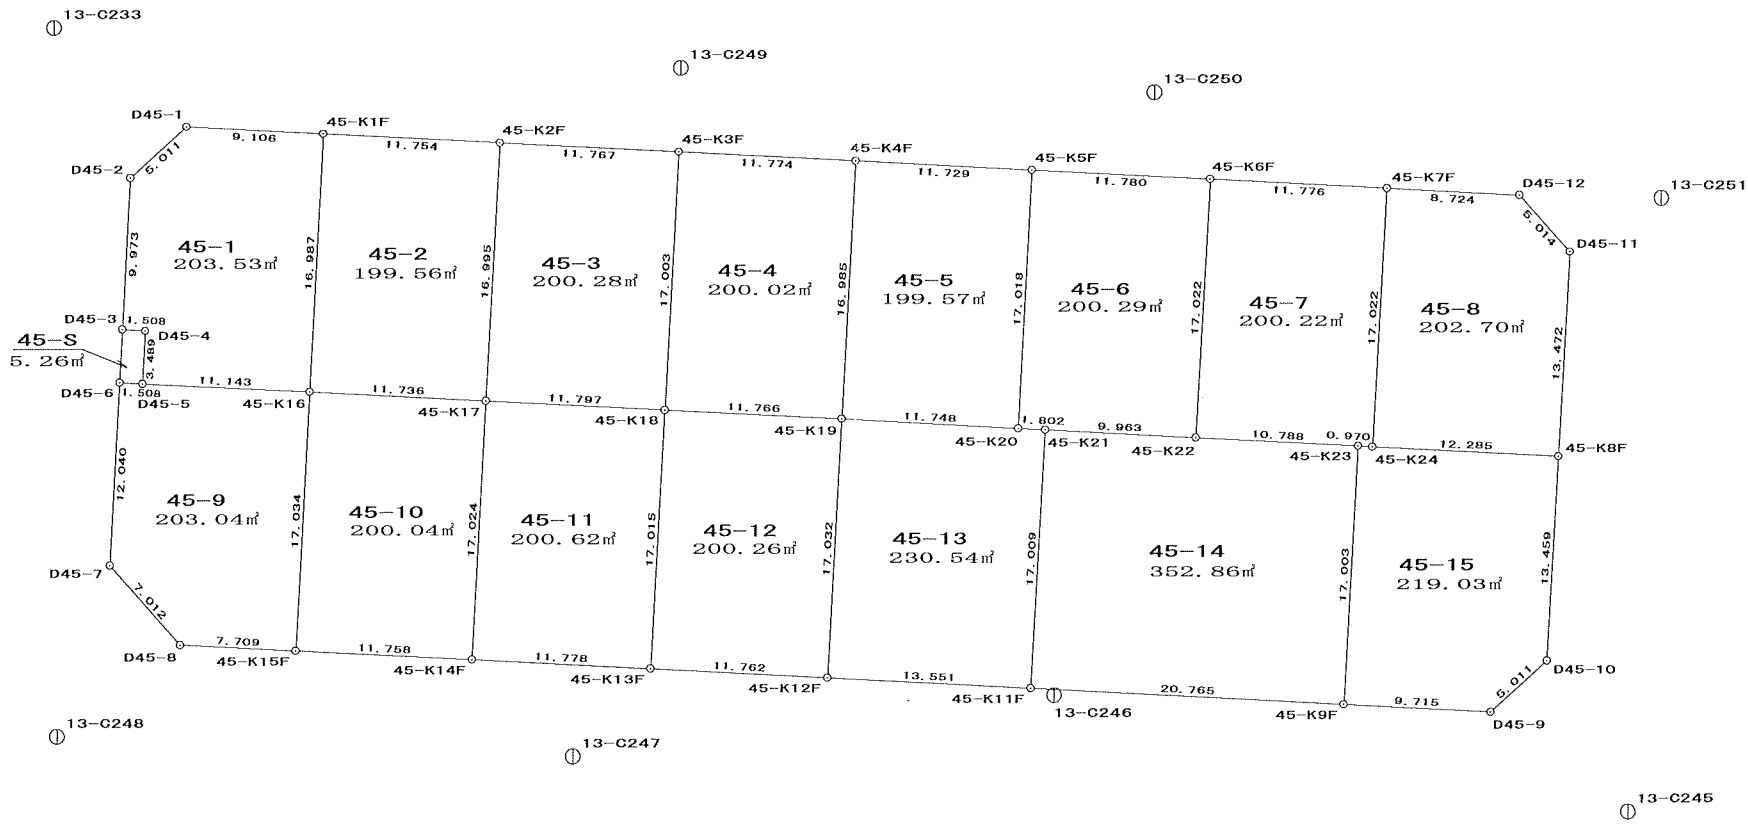


画地出来形確認測量原図

|       |                        |
|-------|------------------------|
| 業務委託名 | 平成14年度 浜田地区画地出来形確認測量業務 |
|-------|------------------------|

|    |     |
|----|-----|
| 縮尺 | 500 |
|----|-----|

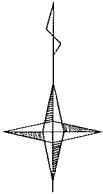

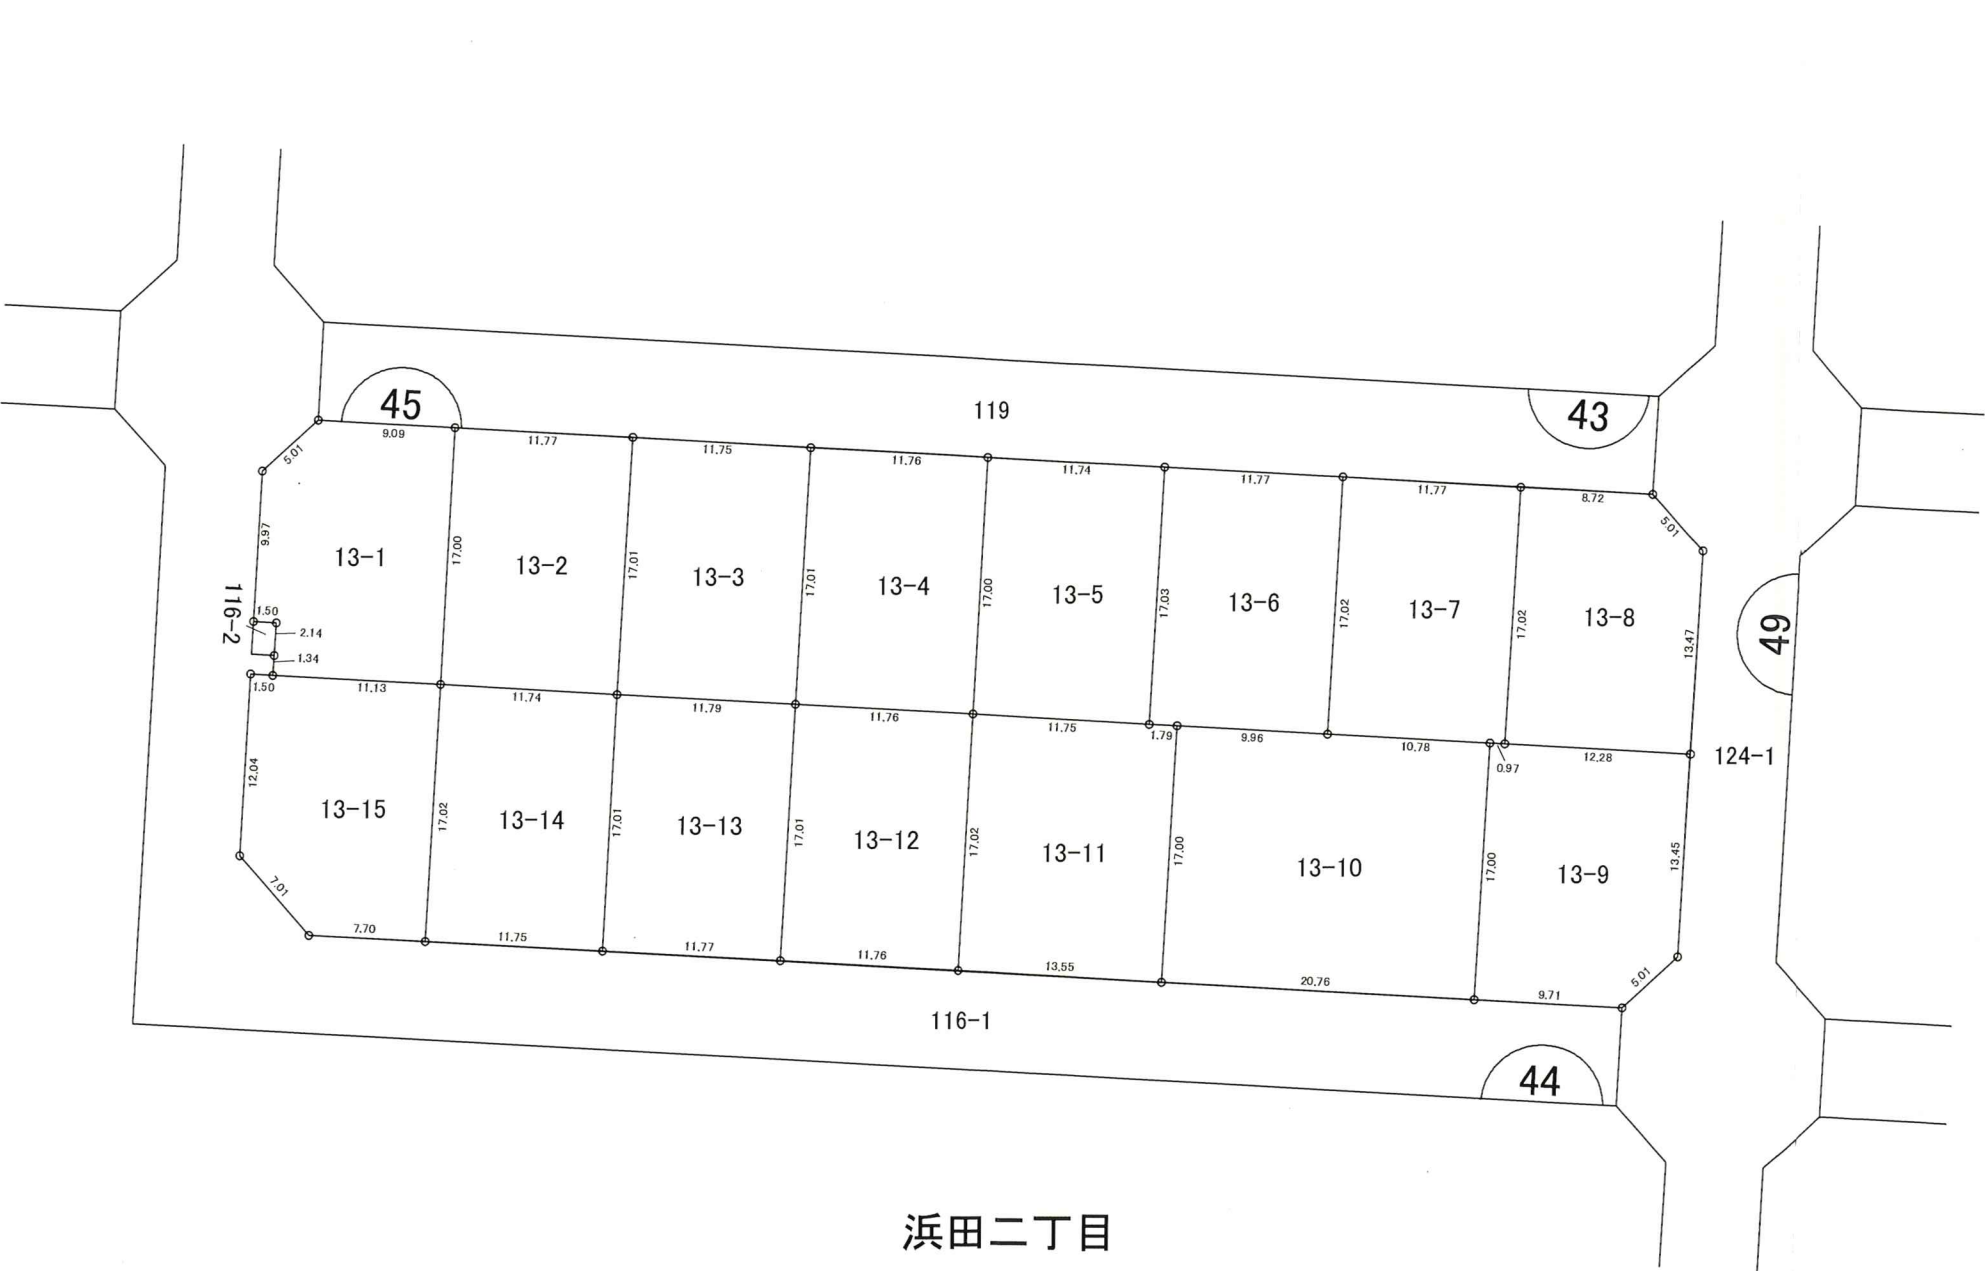

| 凡 例  |           |
|------|-----------|
| 1-1  | 地 番       |
| ---  | 大 字 界     |
| ---- | 字 界       |
| —    | 施 行 地 区 界 |
| □    | 換 地 の 位 置 |

PAGE : 1

\* \* \* 面積 (座標法) 計算書 \* \* \*

| 测点名    | 夹 角       | 方向角       | 距 离    | [1]       | [2]       | [3]           | [2]*[3]        |
|--------|-----------|-----------|--------|-----------|-----------|---------------|----------------|
|        |           |           |        | X(i)      | Y(i)      | X(i+1)-X(i-1) |                |
| D45-1  | 135-00-46 | 227-56-11 | 5.011  | 88919.942 | -6959.285 | -2.893        | 20133.211505   |
| D45-2  | 134-57-38 | 182-53-49 | 9.973  | 88916.585 | -6963.005 | -13.317       | 92726.337585   |
| D45-3  | 90-29-15  | 93-23-04  | 1.508  | 88906.625 | -6963.509 | -10.049       | 69976.301941   |
| D45-4  | 269-34-35 | 182-57-39 | 2.149  | 88906.536 | -6962.004 | -2.235        | 15560.078940   |
| D45-14 | 180-02-02 | 182-59-41 | 1.340  | 88904.390 | -6962.115 | -3.484        | 24256.008660   |
| D45-5  | 89-51-23  | 92-51-04  | 11.138 | 88903.052 | -6962.185 | -1.892        | 13172.454020   |
| 45-K16 | 90-03-06  | 2-54-10   | 17.002 | 88902.498 | -6951.061 | 16.426        | -114178.127986 |
| 45-K1F | 90-01-15  | 272-55-25 | 9.097  | 88919.478 | -6950.200 | 17.444        | -121239.288800 |
|        |           |           |        |           |           | 倍面積           | 406.975865     |
|        |           |           |        |           |           | 面 積           | 203.48         |
|        |           |           |        |           |           | 坪 数           | 61.55          |

\* \* \* 面積 (座標法) 計算書 \* \* \*

[illegible]

PAGE : 2

\* \* \* 面積 (座標法) 計算書 \* \* \*

| 测点名    | 夾 角      | 方向角       | 距 離    | [1]       | [2]       | [3]           | [2]*[3]        |
|--------|----------|-----------|--------|-----------|-----------|---------------|----------------|
|        |          |           |        | X(i)      | Y(i)      | X(i+1)-X(i-1) |                |
| 45-K3F | 90-02-33 | 272-55-12 | 11.758 | 88918.281 | -6926.700 | 17.590        | -121840.653000 |
| 45-K2F | 90-03-55 | 182-59-07 | 17.012 | 88918.880 | -6938.443 | -16.390       | 113721.080770  |
| 45-K17 | 89-56-12 | 92-55-19  | 11.790 | 88901.891 | -6939.329 | -17.590       | 122062.797110  |
| 45-K18 | 89-57-20 | 2-52-39   | 17.012 | 88901.290 | -6927.554 | 16.390        | -113542.610060 |
|        |          |           |        |           |           | 倍面積           | 400.614820     |
|        |          |           |        |           |           | 面 積           | 200.30         |
|        |          |           |        |           |           | 坪 数           | 60.59          |

\* \* \* 面積 (座標法) 計算書 \* \* \*

| 测点名    | 夹 角      | 方向角       | 距 離    | [1]<br>X(i) | [2]<br>Y(i) | [3]<br>X(i+1)-X(i-1) | [2]*[3]        |
|--------|----------|-----------|--------|-------------|-------------|----------------------|----------------|
| 45-K4F | 90-01-49 | 272-55-21 | 11.768 | 88917.681   | -6914.947   | 17.583               | -121585.513101 |
| 45-K3F | 89-57-18 | 182-52-39 | 17.012 | 88918.281   | -6926.700   | -16.391              | 113535.539700  |
| 45-K18 | 90-00-25 | 92-53-04  | 11.764 | 88901.290   | -6927.554   | -17.583              | 121807.181982  |
| 45-K19 | 90-00-28 | 2-53-32   | 17.005 | 88900.698   | -6915.805   | 16.391               | -113356.959755 |
|        |          |           |        |             |             | 倍面積                  | 400.248826     |
|        |          |           |        |             |             | 面 積                  | 200.12         |
|        |          |           |        |             |             | 坪 数                  | 60.53          |

PAGE : 3

\* \* \* 面積 (座標法) 計算書 \* \* \*

[illegible]

\* \* \* 面積 (座標法) 計算書 \* \* \*

| 测点名    | 夾 角       | 方向角       | 距 離    | [1]       | [2]       | [3]           | [2]*[3]        |
|--------|-----------|-----------|--------|-----------|-----------|---------------|----------------|
|        |           |           |        | X(i)      | Y(i)      | X(i+1)-X(i-1) |                |
| 45-K6F | 90-06-52  | 273-00-50 | 11.773 | 88916.465 | -6891.462 | 17.619        | -121420.668978 |
| 45-K5F | 89-49-45  | 182-50-35 | 17.037 | 88917.084 | -6903.219 | -16.397       | 113192.081943  |
| 45-K20 | 89-37-02  | 92-27-37  | 1.794  | 88900.068 | -6904.064 | -17.093       | 118011.165952  |
| 45-K21 | 180-33-58 | 93-01-35  | 9.963  | 88899.991 | -6902.272 | -0.603        | 4162.070016    |
| 45-K22 | 89-52-23  | 2-53-58   | 17.022 | 88899.465 | -6892.323 | 16.474        | -113544.129102 |
|        |           |           |        |           |           | 倍面積           | 400.519831     |
|        |           |           |        |           |           | 面 積           | 200.25         |
|        |           |           |        |           |           | 坪 数           | 60.57          |

PAGE : 4

\*\*\* 面積 (座標法) 計算書 \*\*\*

[illegible]

\*\*\* 面積 (座標法) 計算書 \*\*\*

[illegible]

PAGE : 5

\*\*\* 面積 (座標法) 計算書 \*\*\*

| 测点名     | 夹 角       | 方向角       | 距 离    | [1]<br>X(i) | [2]<br>Y(i) | [3]<br>X(i+1)-X(i-1) | [2]*[3]        |
|---------|-----------|-----------|--------|-------------|-------------|----------------------|----------------|
| D45-5   | 180-27-26 | 273-18-30 | 1.508  | 88903.052   | -6962.185   | 0.641                | -4462.760585   |
| D45-6   | 89-42-54  | 183-01-24 | 12.040 | 88903.139   | -6963.690   | -11.936              | 83118.603840   |
| D45-7   | 135-06-57 | 138-08-21 | 7.012  | 88891.116   | -6964.325   | -17.245              | 120099.784625  |
| D45-8   | 134-47-25 | 92-55-46  | 7.709  | 88885.894   | -6959.646   | -5.616               | 39085.371936   |
| 45-K15F | 90-03-16  | 2-59-02   | 17.021 | 88885.500   | -6951.947   | 16.604               | -115430.127988 |
| 45-K16  | 89-52-02  | 272-51-04 | 11.138 | 88902.498   | -6951.061   | 17.552               | -122005.022672 |
|         |           |           |        |             |             | 倍面积                  | 405.849156     |
|         |           |           |        |             |             | 面 积                  | 202.92         |
|         |           |           |        |             |             | 坪 数                  | 61.38          |

\*\*\* 面積 (座標法) 計算書 \*\*\*

[illegible]

PAGE : 6

\* \* \* 面積 (座標法) 計算書 \* \* \*

| 測点名     | 夾 角      | 方向角       | 距 離    | [1]       | [2]       | [3]           | [2]*[3]        |
|---------|----------|-----------|--------|-----------|-----------|---------------|----------------|
|         |          |           |        | X(i)      | Y(i)      | X(i+1)-X(i-1) |                |
| 45-K18  | 89-56-02 | 272-55-19 | 11.790 | 88901.290 | -6927.554 | 17.593        | -121876.457522 |
| 45-K17  | 90-01-34 | 182-56-53 | 17.014 | 88901.891 | -6939.329 | -16.390       | 113735.602310  |
| 45-K14F | 89-58-54 | 92-55-47  | 11.778 | 88884.900 | -6940.204 | -17.593       | 122099.008972  |
| 45-K13F | 90-03-30 | 2-59-17   | 17.015 | 88884.298 | -6928.441 | 16.390        | -113557.147990 |
|         |          |           |        |           |           | 倍面積           | 401.005770     |
|         |          |           |        |           |           | 面 積           | 200.50         |
|         |          |           |        |           |           | 坪 數           | 60.65          |

\* \* \* 面積 (座標法) 計算書 \* \* \*

| 测点名     | 夾 角      | 方向角       | 距 離    | [1]<br>X(i) | [2]<br>Y(i) | [3]<br>X(i+1)-X(i-1) | [2]*[3]        |
|---------|----------|-----------|--------|-------------|-------------|----------------------|----------------|
| 45-K19  | 89-53-28 | 272-53-04 | 11.764 | 88900.698   | -6915.805   | 17.593               | -121669.757365 |
| 45-K18  | 90-06-13 | 182-59-17 | 17.015 | 88901.290   | -6927.554   | -16.400              | 113611.885600  |
| 45-K13F | 89-56-27 | 92-55-44  | 11.762 | 88884.298   | -6928.441   | -17.593              | 121892.062513  |
| 45-K12F | 90-03-52 | 2-59-36   | 17.024 | 88883.697   | -6916.694   | 16.400               | -113433.781600 |
|         |          |           |        |             |             | 倍面積                  | 400.409148     |
|         |          |           |        |             |             | 面 積                  | 200.20         |
|         |          |           |        |             |             | 坪 數                  | 60.56          |

PAGE : 7

\*\*\* 面積 (座標法) 計算書 \*\*\*

[illegible]

\*\*\* 面積（座標法）計算書 \*\*\*

[illegible]

PAGE : 8

\* \* \* 面積 (座標法) 計算書 \* \* \*

[illegible]