



画地出来形確認測量原図

業務委託名	平成14年度 浜田地区画地出来形確認測量業務
-------	------------------------

縮尺	500
----	-----

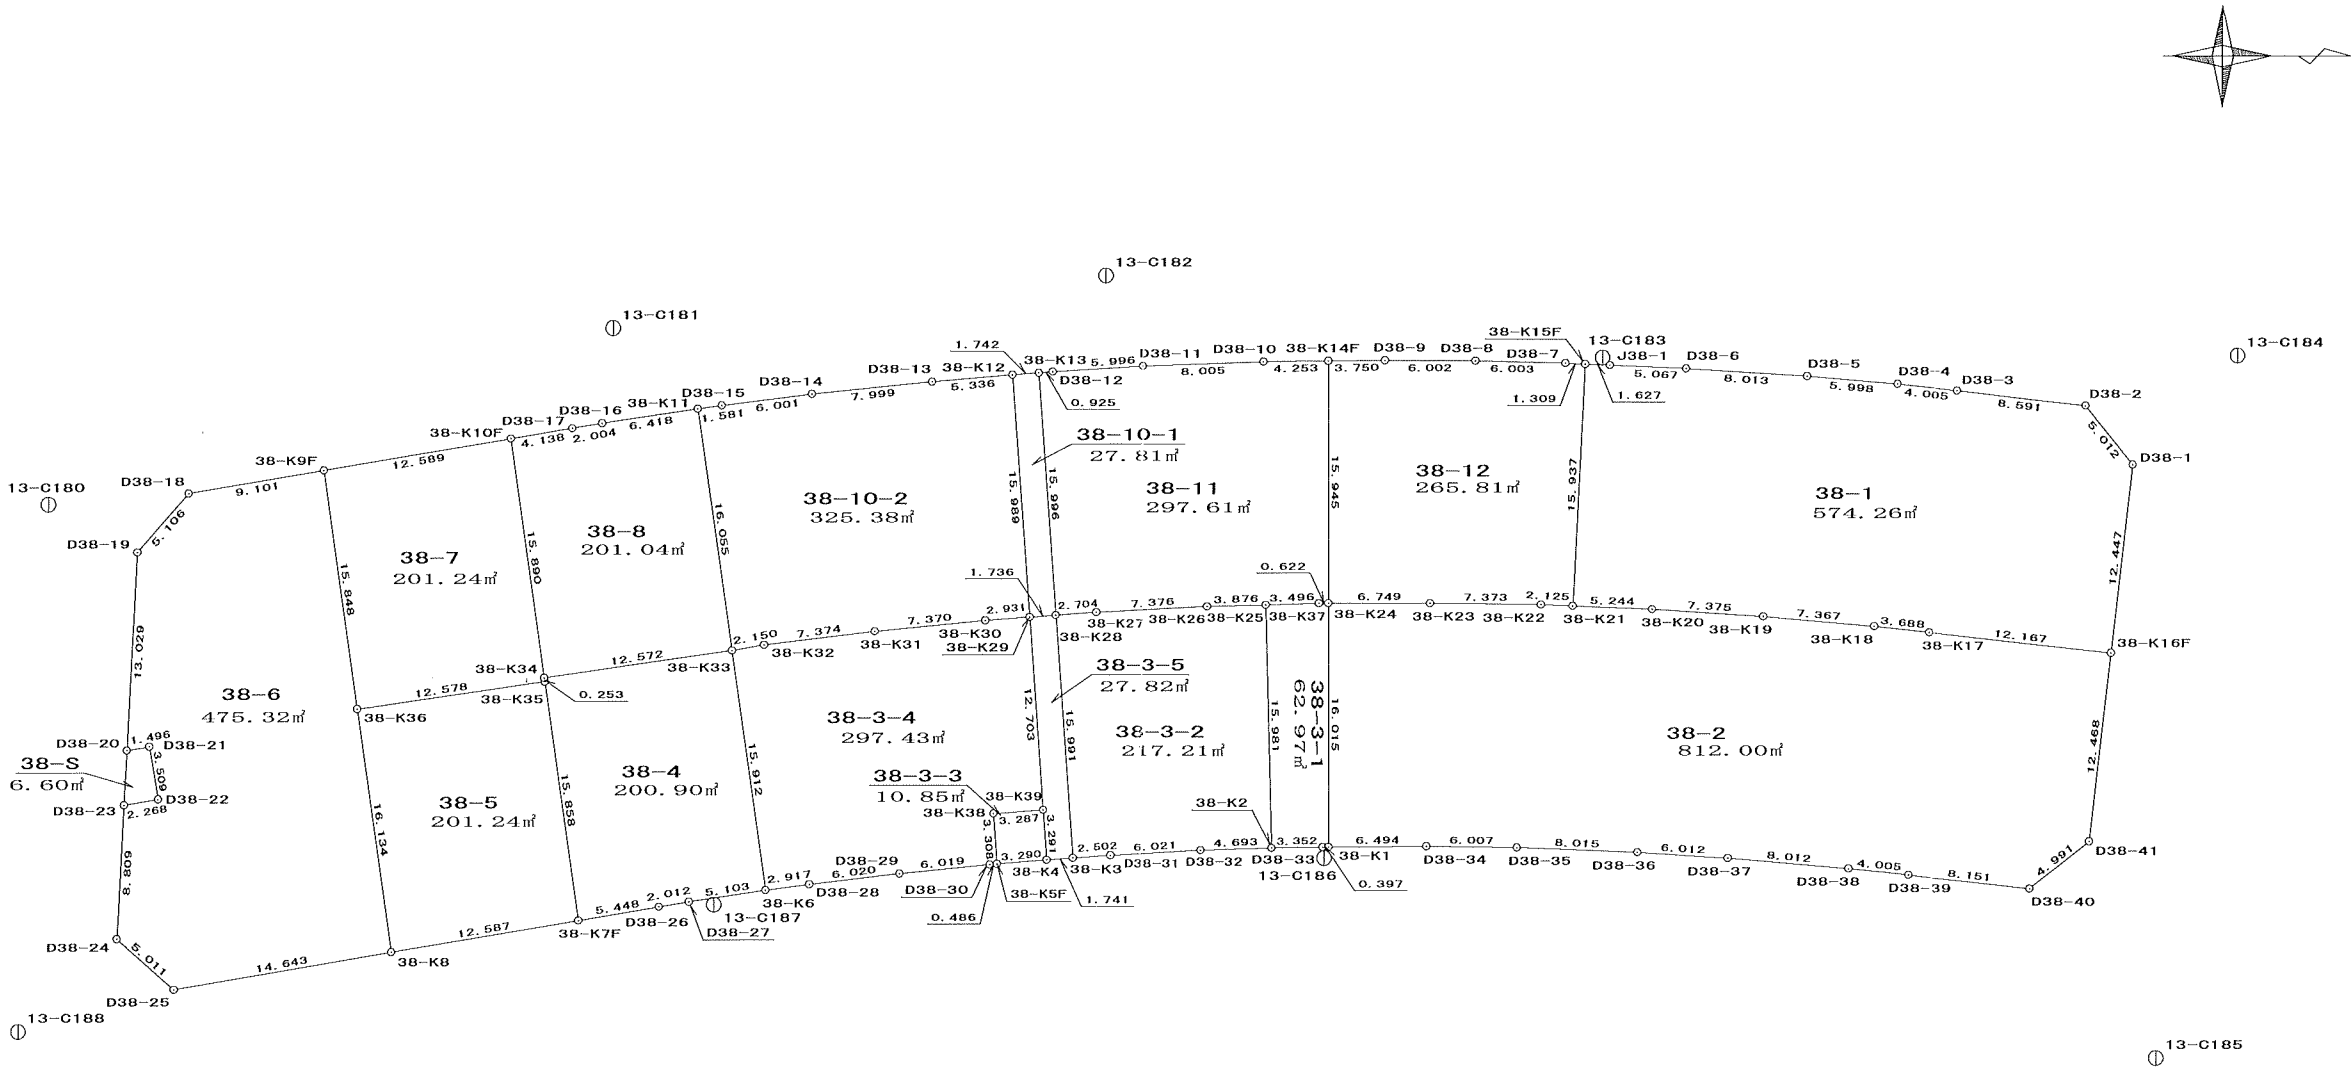

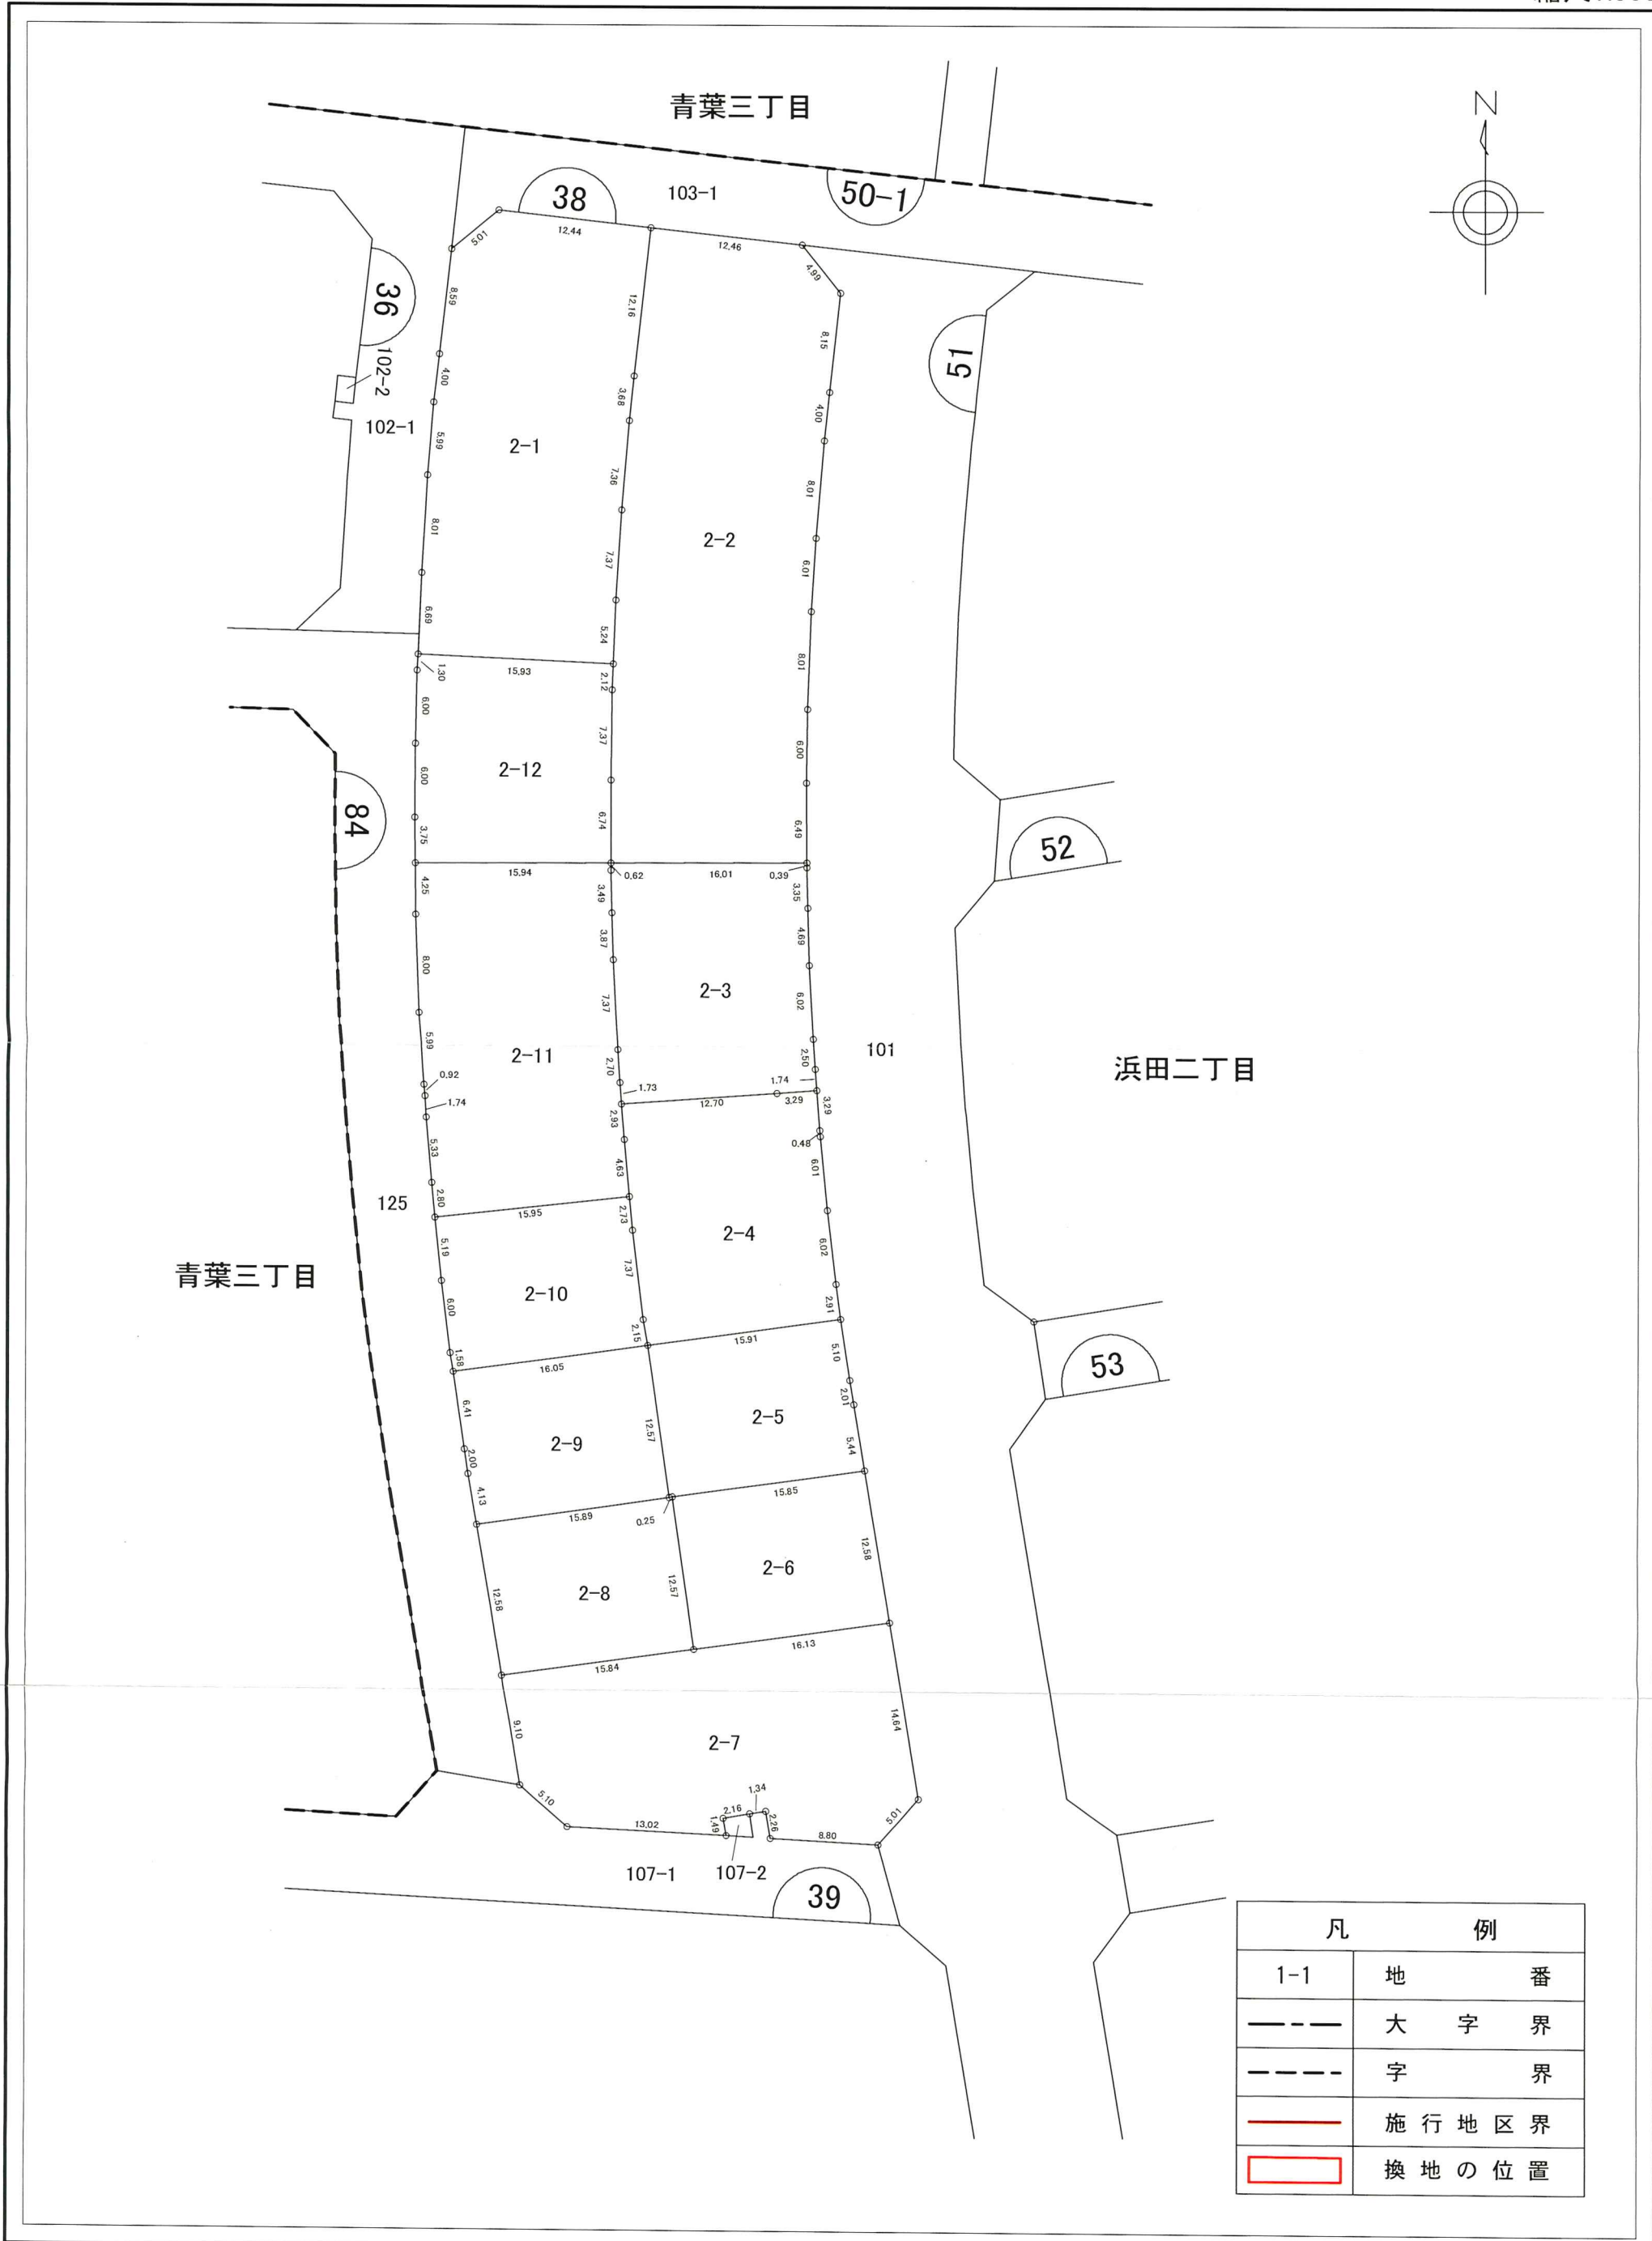

PAGE : 1

*** 面積 (座標法) 計算書 ***

测点名	夾 角	方向角	距 離	[1]	[2]	[3]	[2]*[3]
				X(i)	Y(i)	X(i+1)-X(i-1)	
38-K16F	90-02-53	276-19-59	12.447	89267.365	-6762.814	13.467	-91074.816138
D38-1	134-34-11	230-54-10	5.012	89268.738	-6775.185	-1.788	12114.030780
D38-2	135-31-59	186-26-09	8.591	89265.577	-6779.075	-11.698	79301.619350
D38-3	179-53-59	186-20-08	4.005	89257.040	-6780.038	-12.518	84872.515684
D38-4	178-33-07	184-53-15	5.998	89253.059	-6780.480	-9.957	67513.239360
D38-5	178-37-57	183-31-12	8.013	89247.083	-6780.991	-13.974	94757.568234
D38-6	178-58-18	182-29-30	6.693	89239.085	-6781.483	-14.685	99586.077855
38-K15F	90-08-40	92-38-10	15.937	89232.398	-6781.774	-7.420	50320.763080
38-K21	89-39-32	2-17-42	5.244	89231.665	-6765.854	4.507	-30493.703978
38-K20	181-19-12	3-36-54	7.375	89236.905	-6765.644	12.600	-85247.114400
38-K19	181-19-18	4-56-12	7.367	89244.265	-6765.179	14.700	-99448.131300
38-K18	181-16-29	6-12-41	3.688	89251.605	-6764.545	11.006	-74450.582270
38-K17	180-04-25	6-17-06	12.167	89255.271	-6764.146	15.760	-106602.940960
						倍面積	1148.525297
						面 積	574.26
						坪 数	173.71

PAGE : 3

*** * * 面積 (座標法) 計算書 * * ***

测点名	夾 角	方向角	距 離	[1]	[2]	[3]	[2]*[3]
				X(i)	Y(i)	X(i+1)-X(i-1)	
38-K2	90-46-36	359-08-43	3.352	89211.759	-6749.951	3.807	-25697.063457
D38-33	179-24-43	358-33-26	0.397	89215.111	-6750.001	3.749	-25305.753749
38-K1	91-07-53	269-41-19	16.015	89215.508	-6750.011	0.310	-2092.503410
38-K24	90-29-44	180-11-03	0.622	89215.421	-6766.026	-0.709	4797.112434
38-K37	178-08-39	178-19-42	3.496	89214.799	-6766.028	-4.117	27855.737276
38-K25	90-02-25	88-22-07	15.981	89211.304	-6765.926	-3.040	20568.415040
						倍面積	125.944134
						面 積	62.97
						坪 数	19.04

* * * 面積 (座標法) 計算書 * * *

[illegible]

現場名 : 浜田地区画地出来形確認測量
地区名 : 青森市浜田地区

PAGE : 5

浜田二丁目2-4

*** 面積 (座標法) 計算書 ***

地番 = 38-3-4
測点名

測点名	夾 角	方向角	距 離	[1] X(i)	[2] Y(i)	[3] X(i+1)-X(i-1)	[2]*[3]
38-K6	90-37-44	352-27-22	2.917	89178.199	-6747.181	5.154	-34774.970874
D38-28	180-50-17	353-17-39	6.020	89181.091	-6747.564	8.871	-59857.640244
D38-29	181-01-59	354-19-38	6.019	89187.070	-6748.267	11.969	-80770.007723
D38-30	181-18-37	355-38-15	0.486	89193.060	-6748.862	6.475	-43698.881450
38-K5F	90-05-53	265-44-08	3.308	89193.545	-6748.899	0.239	-1612.986861
38-K38	269-55-14	355-39-22	3.287	89193.299	-6752.198	3.032	-20472.664336
38-K39	90-05-28	265-44-50	12.703	89196.577	-6752.447	2.336	-15773.716192
38-K29	89-59-15	175-44-05	2.931	89195.635	-6765.115	-3.865	26147.169475
38-K30	178-41-24	174-25-29	7.370	89192.712	-6764.897	-10.258	69394.313426
38-K31	178-41-25	173-06-54	7.374	89185.377	-6764.181	-14.656	99135.836736
38-K32	177-05-07	170-12-01	2.150	89178.056	-6763.297	-9.440	63845.523680
38-K33	91-37-37	81-49-38	15.912	89175.937	-6762.931	0.143	-967.099133
倍面積						594.876504	
面 積						297.43	
坪 数						89.97	

PAGE : 6

* * * 面積 (座標法) 計算書 * * *

[illegible]

* * * 面積（座標法）計算書 * * *

[illegible]

PAGE : 7

* * * 面積 (座標法) 計算書 * * *

[illegible]

PAGE : 8

* * * 面積 (座標法) 計算書 * * *

[illegible]

PAGE : 9

*** 面積 (座標法) 計算書 ***

[illegible]

*** 面積 (座標法) 計算書 ***

[illegible]

PAGE : 10

*** * * 面積 (座標法) 計算書 * * ***

测点名	夾 角	方向角	距 離	[1]	[2]	[3]	[2]*[3]
				X(i)	Y(i)	X(i+1)-X(i-1)	
38-K29	90-13-14	355-56-16	1.736	89195.635	-6765.115	2.926	-19794.726490
38-K28	89-47-58	265-44-14	15.996	89197.367	-6765.238	0.543	-3673.524234
38-K13	89-56-59	175-41-13	1.742	89196.178	-6781.190	-2.926	19841.761940
38-K12	90-01-49	85-43-02	15.989	89194.441	-6781.059	-0.543	3682.115037
						倍面積	55.626253
						面 積	27.81
						坪 數	8.41

*** * * 面積 (座標法) 計算書 * * ***

测点名	夾 角	方向角	距 離	[1]	[2]	[3]	[2]*[3]
				X(i)	Y(i)	X(i+1)-X(i-1)	
38-K33	88-24-15	350-12-01	2.150	89175.937	-6762.931	4.410	-29824.525710
38-K32	182-54-53	353-06-54	7.374	89178.056	-6763.297	9.440	-63845.523680
38-K31	181-18-35	354-25-29	7.370	89185.377	-6764.181	14.656	-99135.836736
38-K30	181-18-36	355-44-05	2.931	89192.712	-6764.897	10.258	-69394.313426
38-K29	89-58-57	265-43-02	15.989	89195.635	-6765.115	1.729	-11696.883835
38-K12	89-15-03	174-58-05	5.336	89194.441	-6781.059	-6.509	44137.913031
D38-13	179-12-21	174-10-26	7.999	89189.126	-6780.591	-13.273	89998.784343
D38-14	178-46-20	172-56-46	6.001	89181.168	-6779.779	-13.914	94333.845006
D38-15	179-03-25	172-00-11	1.581	89175.212	-6779.042	-7.522	50991.953924
38-K11	89-47-35	81-47-46	16.055	89173.646	-6778.822	0.725	-4914.645950
						倍面積	650.766967
						面 積	325.38
						坪 数	98.42

PAGE : 11

* * * 面積 (座標法) 計算書 * * *

测点名	夾 角	方向角	距 離	[1] X(i)	[2] Y(i)	[3] X(i+1)-X(i-1)	[2]*[3]
38-K28	90-02-34	355-46-48	2.704	89197.367	-6765.238	3.886	-26289.714868
38-K27	181-16-56	357-03-44	7.376	89200.064	-6765.437	10.063	-68080.592531
38-K26	181-17-48	358-21-32	3.876	89207.430	-6765.815	11.240	-76047.760600
38-K25	179-58-10	358-19-42	3.496	89211.304	-6765.926	7.369	-49858.108694
38-K37	181-51-21	0-11-03	0.622	89214.799	-6766.028	4.117	-27855.737276
38-K24	89-30-50	269-41-53	15.945	89215.421	-6766.026	0.538	-3640.121988
38-K14F	89-38-31	179-20-24	4.253	89215.337	-6781.971	-4.337	29413.408227
D38-10	178-29-52	177-50-16	8.005	89211.084	-6781.922	-12.252	83092.108344
D38-11	178-42-03	176-32-19	5.996	89203.085	-6781.620	-13.984	94834.174080
D38-12	179-14-36	175-46-55	0.925	89197.100	-6781.258	-6.907	46838.149006
38-K13	89-57-19	85-44-14	15.996	89196.178	-6781.190	0.267	-1810.577730
						倍面積	595.225970
						面 積	297.61
						坪 數	90.02

PAGE : 12

*** 面積 (座標法) 計算書 ***

[illegible]