

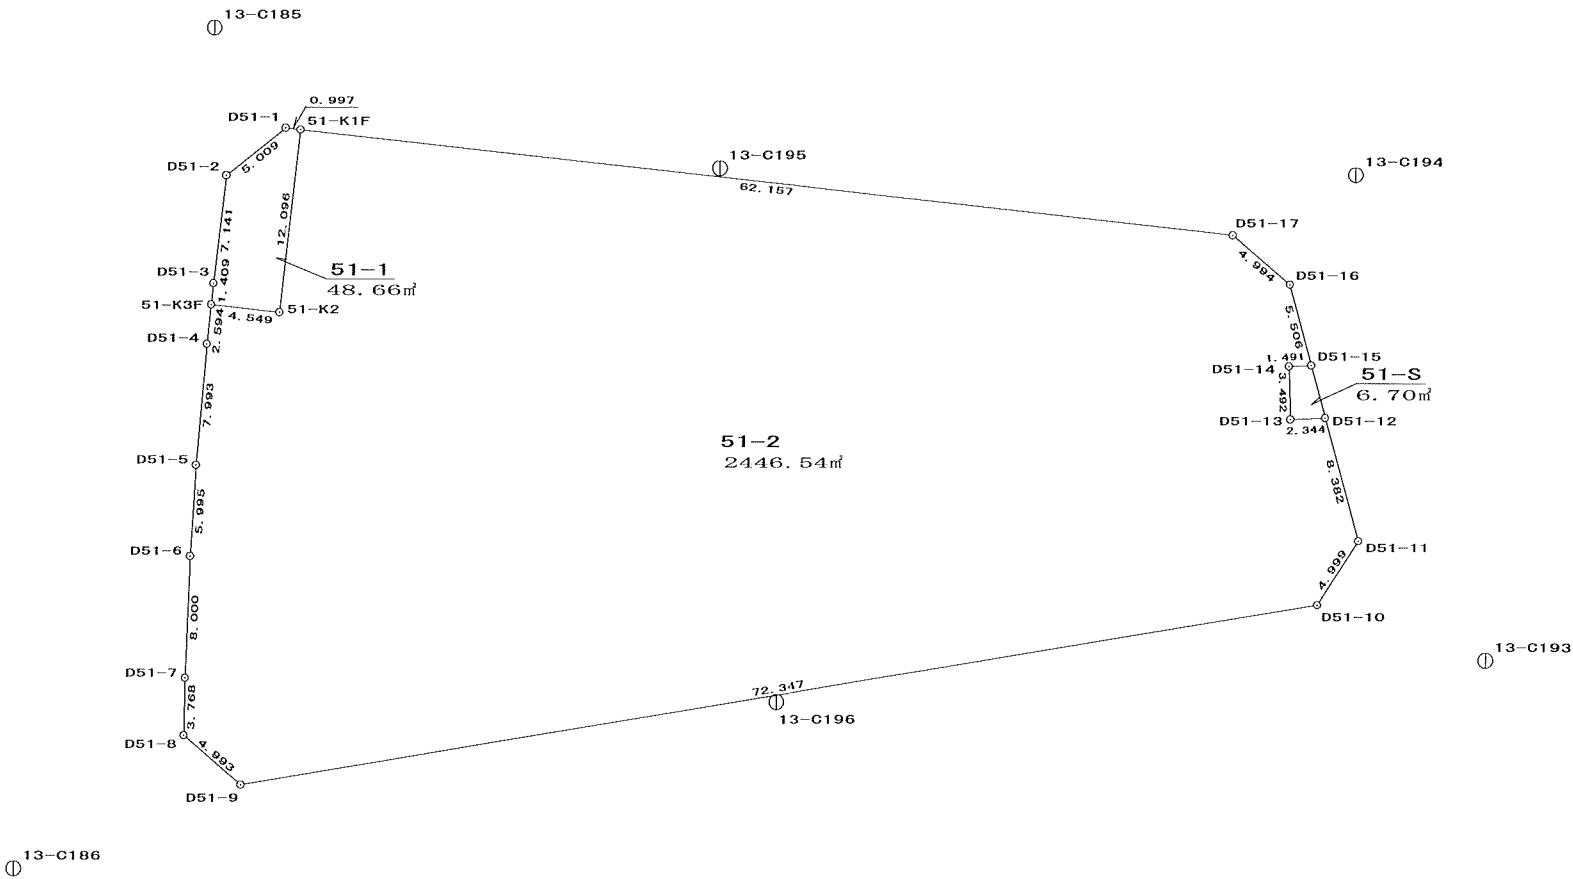


画地出来形確認測量原図

業務委託名	平成14年度 浜田地区画地出来形確認測量業務
-------	------------------------

縮尺	500
----	-----

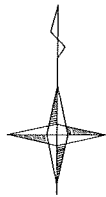

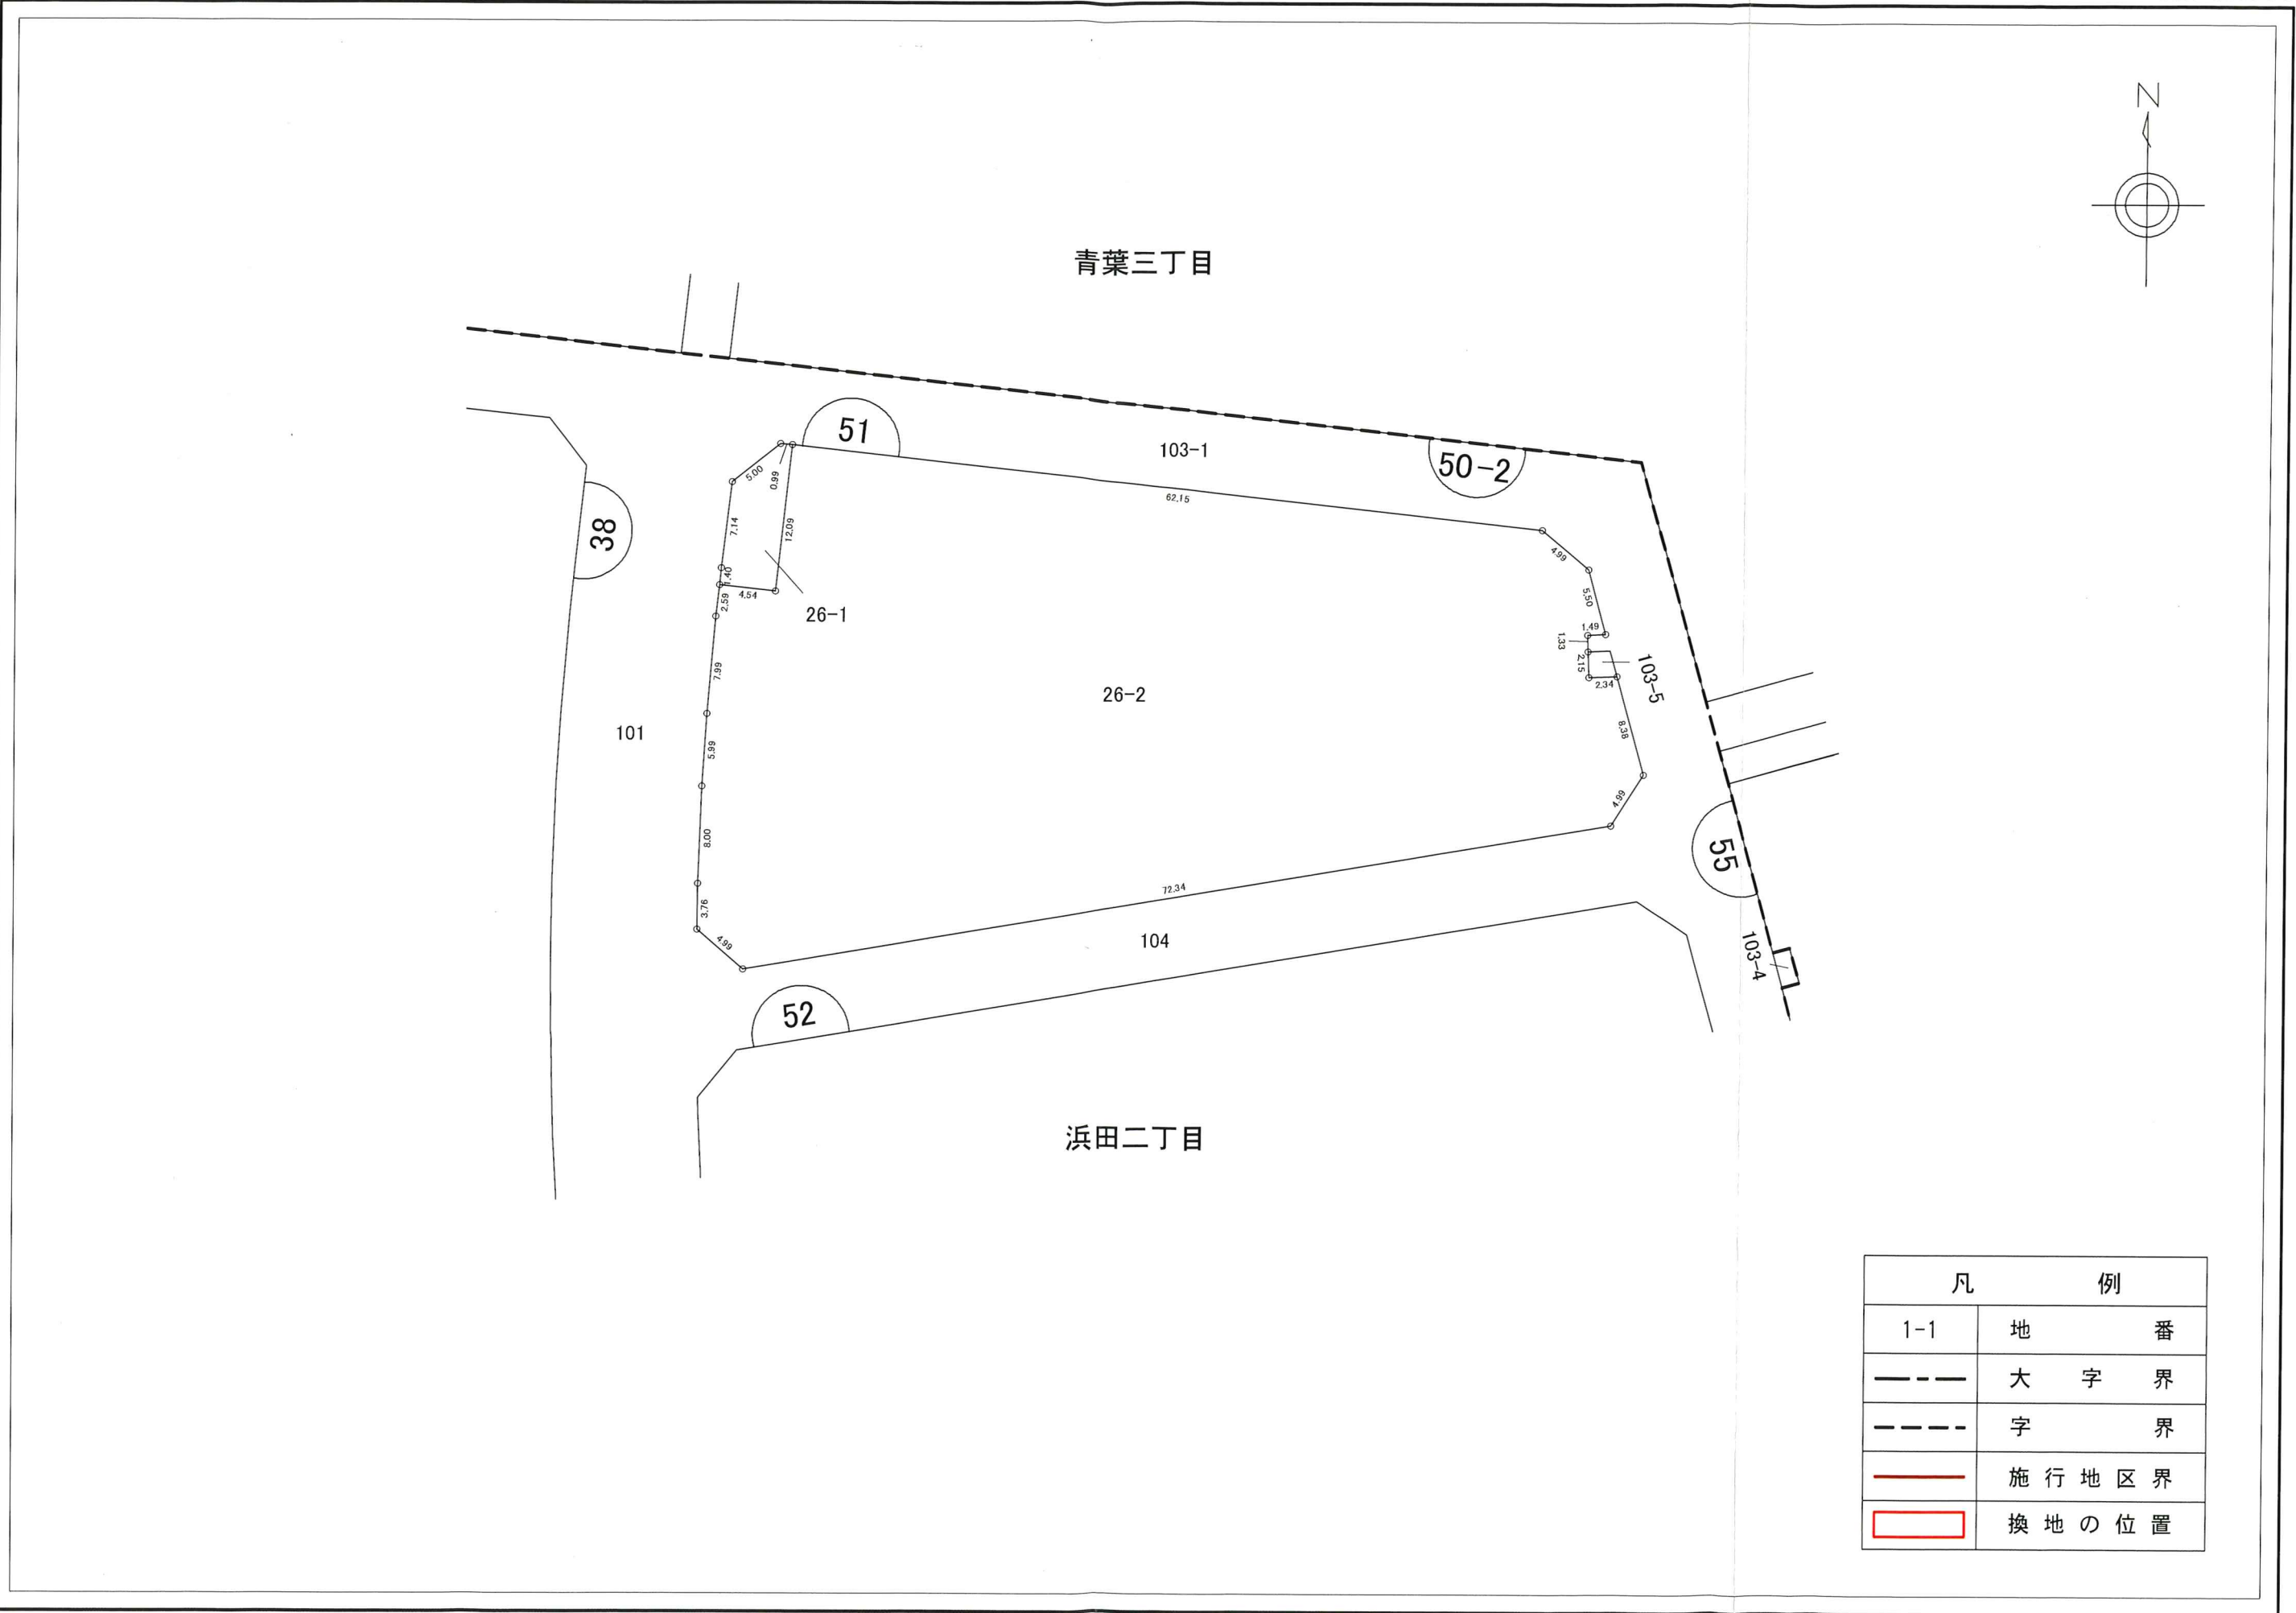

PAGE : 1

*** 面積（座標法）計算書 ***

测点名	夹 角	方向角	距 離	[1]	[2]	[3]	[2]*[3]
				X(i)	Y(i)	X(i+1)-X(i-1)	
D51-1	135-00-16	231-16-52	5.009	89263.908	-6731.448	-3.024	20355.898752
D51-2	135-16-50	186-33-42	7.141	89260.775	-6735.356	-10.227	68882.485812
D51-3	179-30-33	186-04-15	1.409	89253.681	-6736.172	-8.495	57223.781140
51-K3F	90-15-55	96-20-10	4.549	89252.280	-6736.321	-1.903	12819.218863
51-K2	90-02-19	6-22-29	12.096	89251.778	-6731.800	11.519	-77543.604200
51-K1F	89-54-07	276-16-36	0.997	89263.799	-6730.457	12.130	-81640.443410
						倍面積	97.336957
						面 積	48.66
						坪 数	14.72

