



画地出来形確認測量原図

業務委託名	平成14年度 浜田地区画地出来形確認測量業務
-------	------------------------

縮尺	500
----	-----

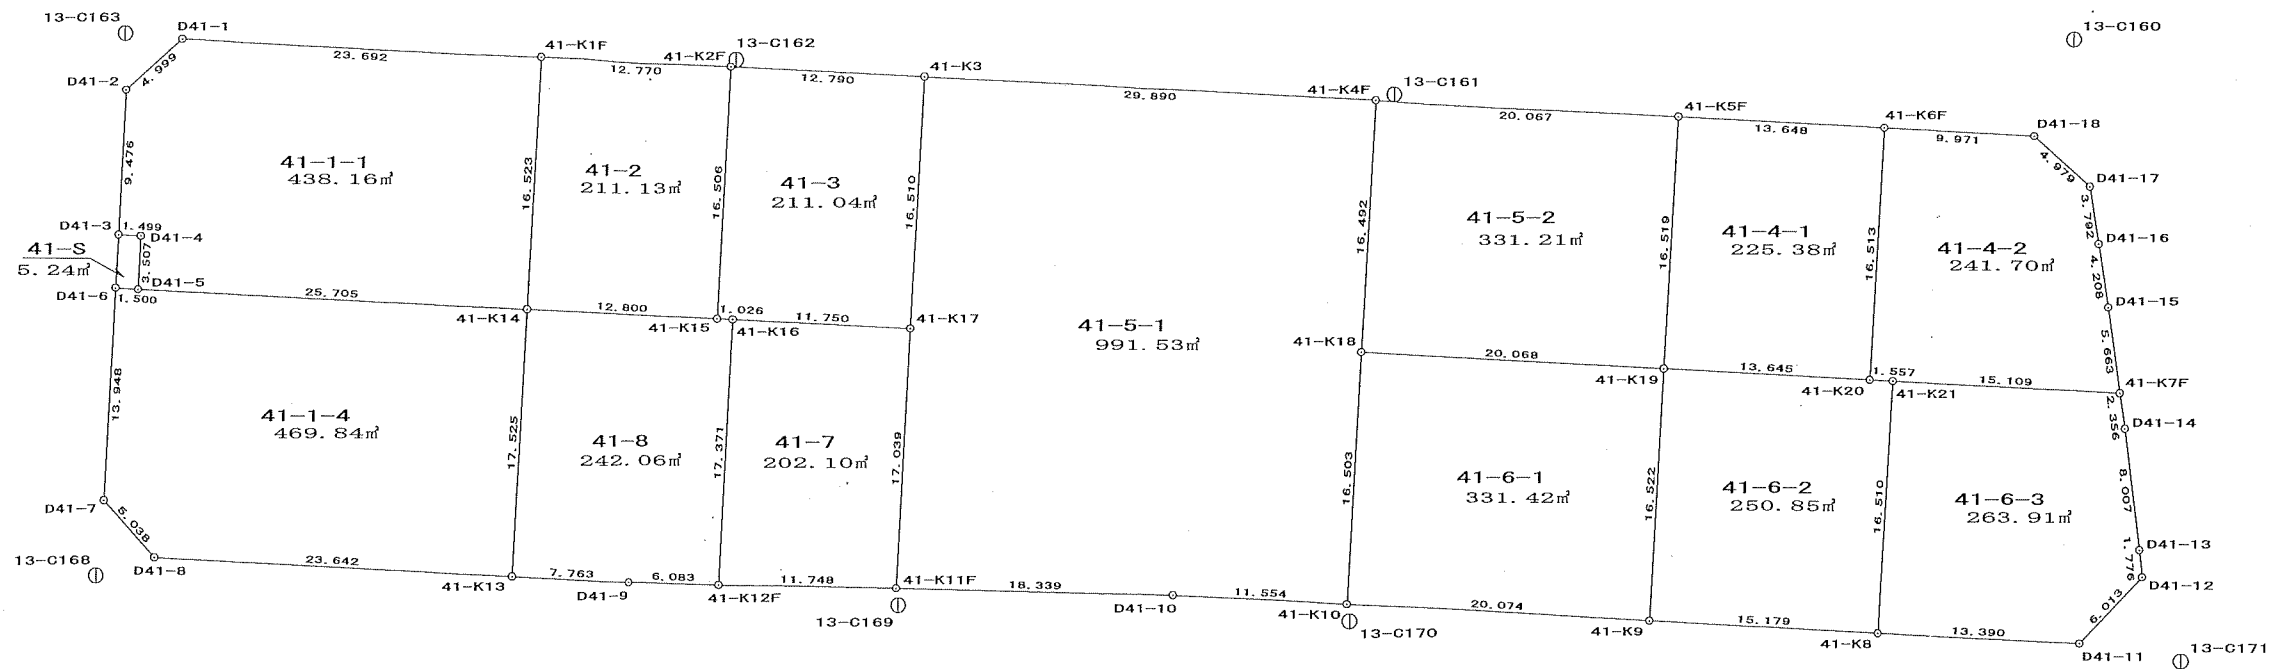

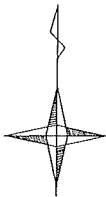

浜田二丁目7-1

[illegible]

浜田二丁目7-12

[illegible]

現場名 : 浜田地区面地出来形確認測量
地区名 : 青森市浜田地区

*** 面積 (座標法) 計算書 ***

浜田二丁目7-2

地番 = 41-2
測点名

	夾 角	方向角	距 離	[1] X(i)	[2] Y(i)	[3] X(i+1)-X(i-1)	[2]*[3]
41-K2F	89-59-43	272-53-42	12.770	89047.678	-6814.114	17.130	-116725.772820
41-K1F	90-06-21	183-00-03	16.523	89048.323	-6826.868	-15.855	108239.992140
41-K14	89-49-14	92-49-17	12.800	89031.823	-6827.733	-17.130	116959.066290
41-K15	90-04-42	2-53-59	16.506	89031.193	-6814.949	15.855	-108051.016395
						倍面積	422.269215
						面 積	211.13
						坪 数	63.86

*** 面積 (座標法) 計算書 ***

浜田二丁目7-3

地番 = 41-3
測点名

	夾 角	方向角	距 離	[1] X(i)	[2] Y(i)	[3] X(i+1)-X(i-1)	[2]*[3]
41-K3	89-56-50	272-53-42	12.790	89047.032	-6801.340	17.134	-116534.159560
41-K2F	90-00-17	182-53-59	16.506	89047.678	-6814.114	-15.839	107928.751646
41-K15	90-06-58	93-00-57	1.026	89031.193	-6814.949	-16.539	112712.441511
41-K16	179-53-12	92-54-09	11.750	89031.139	-6813.924	-0.649	4422.236676
41-K17	90-02-43	2-56-52	16.510	89030.544	-6802.189	15.893	-108107.189777
						倍面積	422.080496
						面 積	211.04
						坪 数	63.83

現場名 : 浜田地区画地出来形確認測量
地区名 : 青森市浜田地区

*** 面積 (座標法) 計算書 ***

浜田二丁目7-6

地番 = 41-4-1
測点名

供田二丁目7-6

地番 = 41-4-1				[1]	[2]	[3]	[2]*[3]
測点名	夾 角	方向角	距 離	X(i)	Y(i)	X(i+1)-X(i-1)	
41-K6F	89-59-37	272-56-24	13.648	89043.768	-6737.819	17.195	-115856.797705
41-K5F	89-59-44	182-56-08	16.519	89044.468	-6751.449	-15.797	106652.639853
41-K19	89-59-48	92-55-56	13.645	89027.971	-6752.295	-17.195	116105.712525
41-K20	90-00-51	2-56-47	16.517	89027.273	-6738.668	15.797	-106450.738396
						倍面積	450.816277
						面 積	225.40
						坪 数	68.18

*** 面積 (座標法) 計算書 ***

浜田二丁目7-7

地番 = 41-4-2
測点名

供田二丁目7-7

地番 = 41-4-2				[1]	[2]	[3]	[2]*[3]
測点名	夾 角	方向角	距 離	X(i)	Y(i)	X(i+1)-X(i-1)	
41-K6F	90-00-11	182-56-47	16.517	89043.768	-6737.819	-15.983	107690.561077
41-K20	89-48-54	92-45-41	1.557	89027.273	-6738.668	-16.570	111659.728760
41-K21	180-06-51	92-52-32	15.109	89027.198	-6737.113	-0.833	5612.015129
41-K7F	78-42-24	351-34-56	5.663	89026.440	-6722.023	4.844	-32561.479412
D41-15	179-06-19	350-41-15	4.208	89032.042	-6722.852	9.755	-65581.421260
D41-16	179-57-52	350-39-07	3.792	89036.195	-6723.533	7.895	-53082.293035
D41-17	141-08-56	311-48-03	4.979	89039.937	-6724.149	7.061	-47479.216089
D41-18	141-08-33	272-56-36	9.971	89043.256	-6727.861	3.831	-25774.435491
						倍面積	483.459679
						面 積	241.72
						坪 数	73.12

浜田二丁目7-4・7-5

[illegible]

浜田二丁目7-5

[illegible]

浜田二丁目7-9

地番 = 測点名	夾 角	方向角	距 離	[1] X(i)	[2] Y(i)	[3] X(i+1)-X(i-1)	[2]*[3]
41-K21	89-44-02	272-45-41	1.557	89027.198	-6737.113	16.562	-111580.065506
41-K20	180-10-15	272-55-56	13.645	89027.273	-6738.668	0.773	-5208.990364
41-K19	90-01-00	182-56-56	16.522	89027.971	-6752.295	-15.802	106699.765590
41-K9	89-55-16	92-52-12	15.179	89011.471	-6753.145	-17.260	116559.282700
41-K8	90-09-27	3-01-39	16.510	89010.711	-6737.985	15.727	-105968.290095
						倍面積	501.702325
						面 積	250.85
						坪 數	75.88

浜田二丁目7-8

* * * 面積 (座標法) 計算書 * * *

[illegible]

浜田二丁目7-10

地番 = 41-7				[1]	[2]	[3]	[2]*[3]
测点名	夹 角	方向角	距 離	X(i)	Y(i)	X(i+1)-X(i-1)	
41-K17	89-57-32	272-54-09	11.750	89030.544	-6802.189	17.612	-119800.152668
41-K16	90-01-04	182-55-13	17.371	89031.139	-6813.924	-16.753	114153.668772
41-K12F	88-22-03	91-17-16	11.748	89013.791	-6814.809	-17.612	120022.416108
41-K11F	91-39-21	2-56-37	17.039	89013.527	-6803.064	16.753	-113971.731192
						倍面積	404.201020
						面 積	202.10
						坪 数	61.13

浜田二丁目7-11

地番 = 41-8 測点名	夾 角	方向角	距 離	[1] X(i)	[2] Y(i)	[3] X(i+1)-X(i-1)	[2]*[3]
41-K16	90-05-44	273-00-57	1.026	89031.139	-6813.924	17.402	-118575.905448
41-K15	179-48-20	272-49-17	12.800	89031.193	-6814.949	0.684	-4661.425116
41-K14	90-09-19	182-58-36	17.525	89031.823	-6827.733	-16.871	115190.683443
41-K13	89-55-57	92-54-33	7.763	89014.322	-6828.643	-17.895	122198.566485
D41-9	178-22-53	91-17-26	6.083	89013.928	-6820.890	-0.531	3621.892590
41-K12F	91-37-47	2-55-13	17.371	89013.791	-6814.809	17.211	-117289.677699
						倍面積	484.134255
						面 積	242.06
						坪 數	73.22