

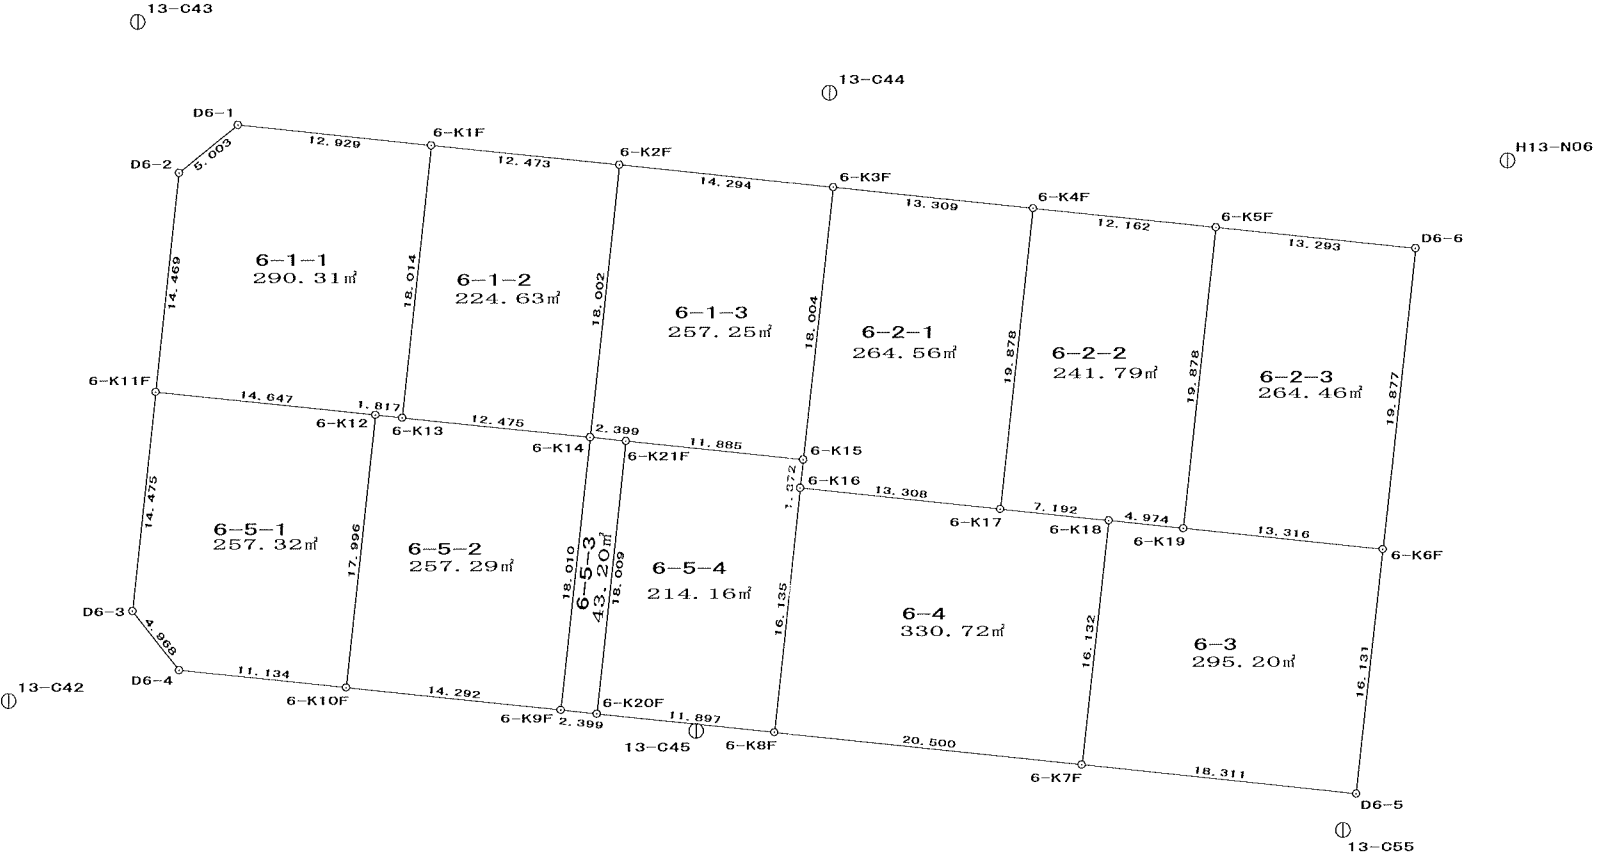


画地出来形確認測量原図


業務委託名	平成14年度 浜田地区画地出来形確認測量業務
-------	------------------------

縮尺	500
----	-----

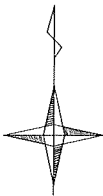

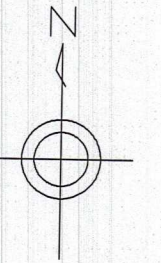

東大野一丁目

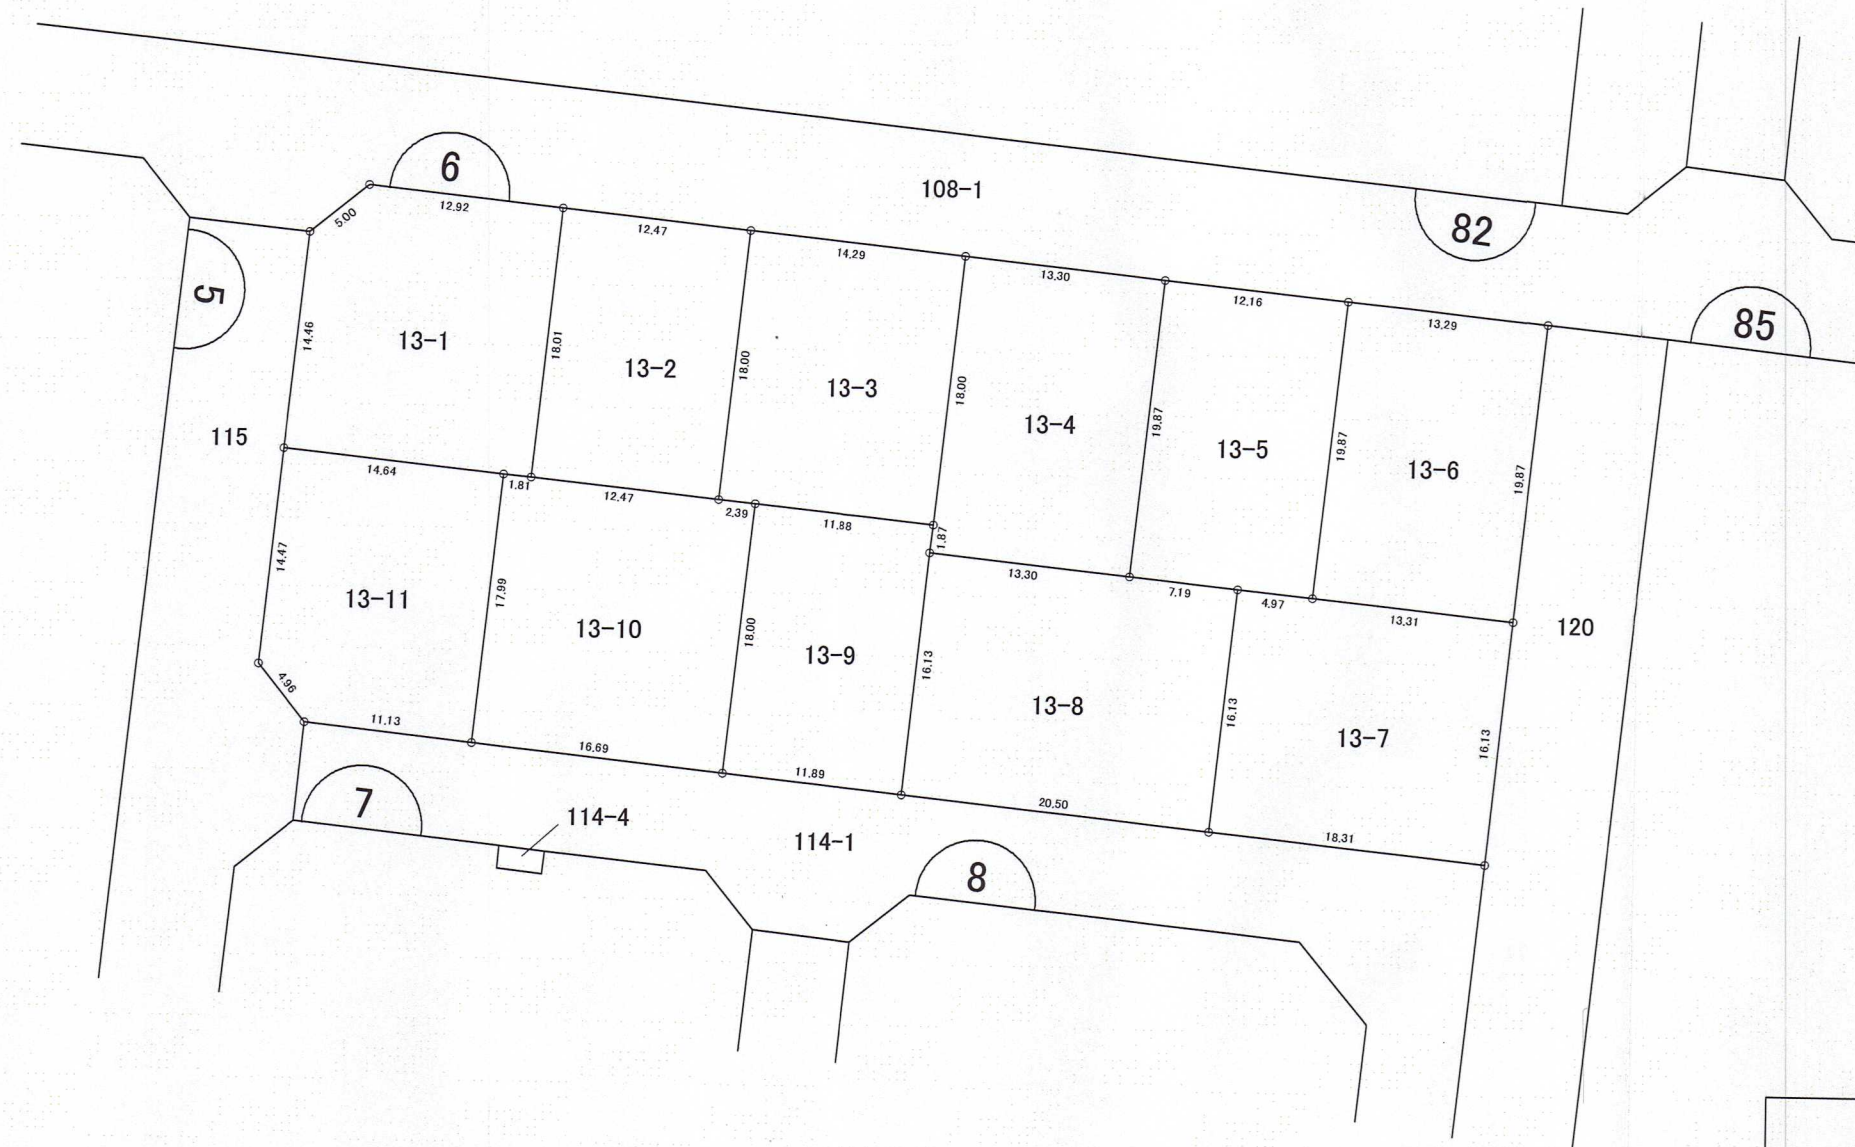

凡 例	
1-1	地 番
----	大 字 界
----	字 界
—	施行地区界
	換地の位置

PAGE : 1

* * * 面積 (座標法) 計算書 * * *

测点名	夾 角	方向角	距 離	[1]	[2]	[3]	[2]*[3]
				X(i)	Y(i)	X(i+1)-X(i-1)	
D6-1	134-57-18	230-55-18	5.003	89172.564	-7683.746	-1.810	13907.580260
D6-2	135-01-44	185-57-02	14.469	89169.410	-7687.630	-17.545	134879.468350
6-K11F	90-02-29	95-59-31	14.647	89155.019	-7689.130	-15.920	122410.949600
6-K12	179-54-59	95-54-30	1.817	89153.490	-7674.563	-1.716	13169.550108
6-K13	90-02-49	5-57-19	18.014	89153.303	-7672.756	17.730	-136037.963880
6-K1F	90-00-41	275-58-00	12.929	89171.220	-7670.887	19.261	-147748.954507
						倍面積	580.629931
						面 積	290.31
						坪 数	87.82

* * * 面積 (座標法) 計算書 * * *

[illegible]

PAGE : 2

* * * 面積 (座標法) 計算書 * * *

测点名	夾 角	方向角	距 離	[1]	[2]	[3]	[2]*[3]
				X(i)	Y(i)	X(i+1)-X(i-1)	
6-K2F	89-59-01	185-56-48	18.002	89169.924	-7658.482	-16.420	125752.274440
6-K14	90-02-05	95-58-53	2.399	89152.019	-7660.347	-18.155	139073.599785
6-K21F	179-59-16	95-58-09	11.885	89151.769	-7657.961	-1.486	11379.730046
6-K15	90-00-31	5-58-40	18.004	89150.533	-7646.140	16.670	-127461.153800
6-K3F	89-59-07	275-57-47	14.294	89168.439	-7644.265	19.391	-148229.942615
						倍面積	514.507856
						面 積	257.25
						坪 数	77.81

* * * 面積 (座標法) 計算書 * * *

[illegible]

PAGE : 3

*** 面積 (座標法) 計算書 ***

测点名	夹 角	方向角	距 离	[1]	[2]	[3]	[2]*[3]
				X(i)	Y(i)	X(i+1)-X(i-1)	
6-K4F	90-00-22	185-58-18	19.878	89167.055	-7631.028	-18.506	141219.804168
6-K17	89-59-25	95-57-43	7.192	89147.285	-7633.096	-20.517	156608.230632
6-K18	180-00-57	95-58-40	4.974	89146.538	-7625.943	-1.265	9646.817895
6-K19	89-58-55	5-57-35	19.878	89146.020	-7620.996	19.253	-146727.035988
6-K5F	90-00-21	275-57-56	12.162	89165.791	-7618.932	21.035	-160264.234620
						倍面积	483.582087
						面 积	241.79
						坪 数	73.14

*** 面積 (座標法) 計算書 ***

测点名	夾 角	方向角	距 離	[1] X(i)	[2] Y(i)	[3] X(i+1)-X(i-1)	[2]*[3]
6-K5F	89-59-47	185-57-35	19.878	89165.791	-7618.932	-18.390	140112.159480
6-K19	89-59-51	95-57-26	13.316	89146.020	-7620.996	-21.153	161206.928388
6-K6F	89-56-11	5-53-37	19.877	89144.638	-7607.752	18.390	-139906.559280
D6-6	90-04-11	275-57-48	13.293	89164.410	-7605.711	21.153	-160883.604783
						倍面積	528.923805
						面 積	264.46
						坪 数	79.99

PAGE : 4

*** 面積 (座標法) 計算書 ***

[illegible]

*** 面積（座標法） 計算書 ***

[illegible]

PAGE : 5

*** 面積 (座標法) 計算書 ***

测点名	夹 角	方向角	距 离	[1] X(i)	[2] Y(i)	[3] X(i+1)-X(i-1)	[2]*[3]
6-K11F	89-57-22	185-56-53	14.475	89155.019	-7689.130	-12.868	98943.724840
D6-3	135-16-11	141-13-04	4.968	89140.622	-7690.630	-18.270	140507.810100
D6-4	134-44-30	95-57-34	11.134	89136.749	-7687.518	-5.029	38660.528022
6-K10F	90-02-25	5-59-59	17.996	89135.593	-7676.444	16.741	-128511.349004
6-K12	89-59-32	275-59-31	14.647	89153.490	-7674.563	19.426	-149086.060838
						倍面积	514.653120
						面 积	257.32
						坪 数	77.84

* * * 面積 (座標法) 計算書 * * *

[illegible]

PAGE : 6

*** 面積 (座標法) 計算書 ***

测点名	夾 角	方向角	距 離	[1] X(i)	[2] Y(i)	[3] X(i+1)-X(i-1)	[2]*[3]
6-K21F	90-01-46	185-59-55	18.009	89151.769	-7657.961	-16.674	127688.841714
6-K20F	89-57-52	95-57-47	11.897	89133.859	-7659.843	-19.146	146655.354078
6-K8F	90-00-22	5-58-09	16.135	89132.623	-7648.010	14.812	-113282.324120
6-K16	179-55-05	5-53-14	1.872	89148.671	-7646.332	17.910	-136945.806120
6-K15	90-04-55	275-58-09	11.885	89150.533	-7646.140	3.098	-23687.741720
						倍面積	428.323832
						面 積	214.16
						坪 數	64.78