

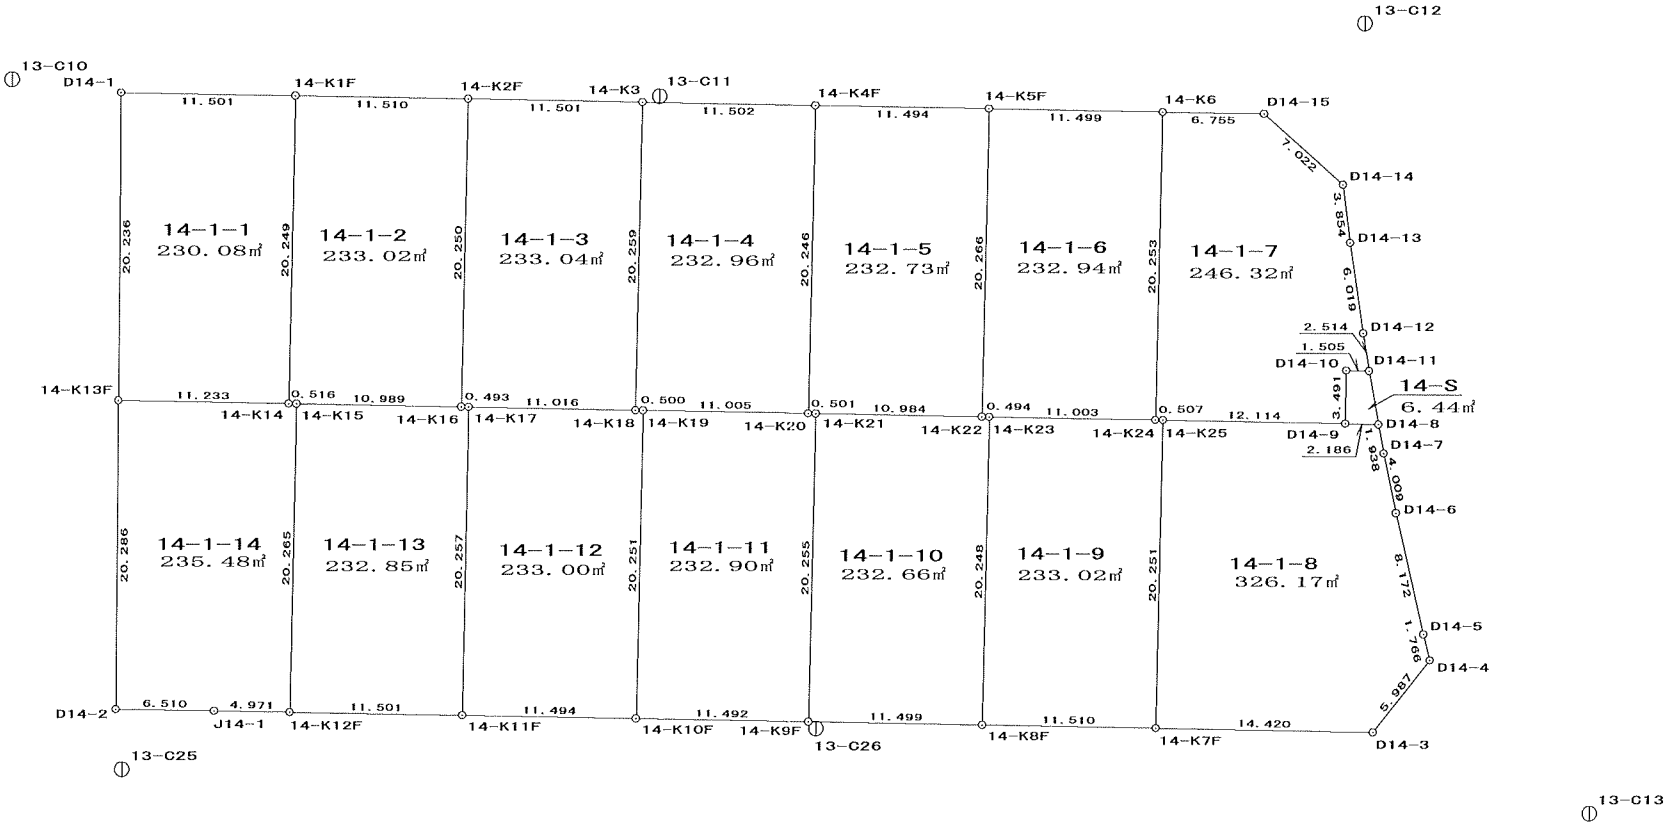


画地出来形確認測量原図

業務委託名	平成14年度 浜田地区画地出来形確認測量業務
-------	------------------------

縮尺	500
----	-----

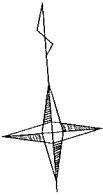

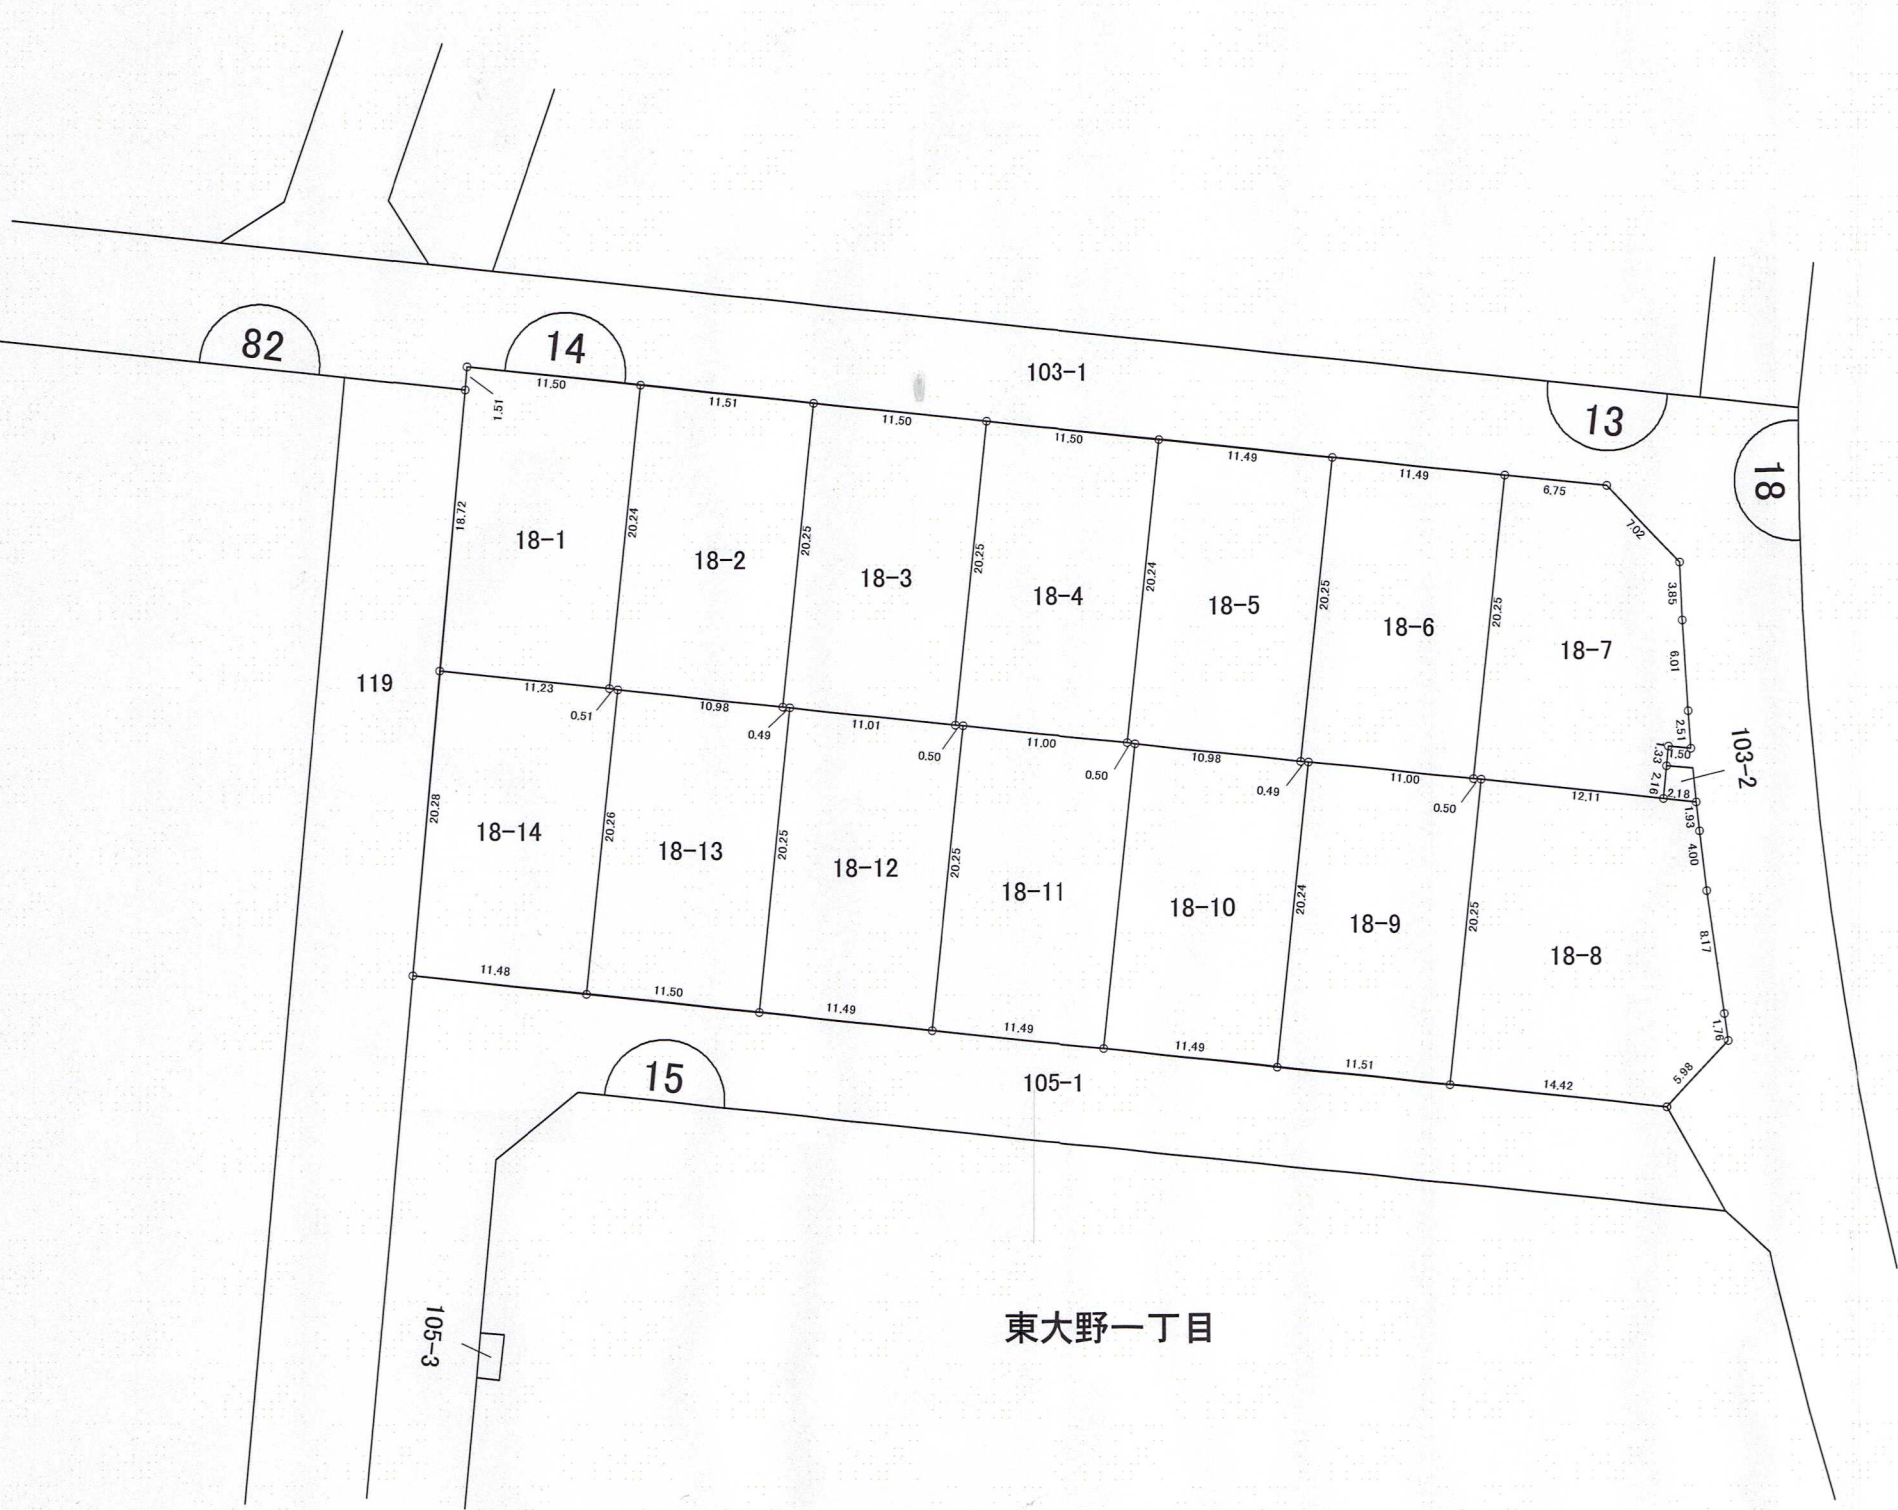

凡 例	
1-1	地 番
---	大 字 界
---	字 界
—	施 行 地 区 界
□	換 地 の 位 置

PAGE : 1

* * * 面積 (座標法) 計算書 * * *

测点名	夾 角	方向角	距 離	[1] X(i)	[2] Y(i)	[3] X(i+1)-X(i-1)	[2]*[3]
D14-1	89-32-40	185-32-01	1.514	89347.820	-7580.826	-0.307	2327.313582
D14-16	179-41-07	185-13-08	18.723	89346.313	-7580.972	-20.152	152771.747744
14-K13F	90-50-23	96-03-31	11.237	89327.668	-7582.675	-19.831	150372.027925
14-K14	89-55-53	5-59-24	20.249	89326.482	-7571.501	18.952	-143495.086952
14-K1F	89-59-57	275-59-21	11.501	89346.620	-7569.388	21.338	-161515.601144
						倍面積	460.401155
						面 積	230.20
						坪 数	69.63

* * * 面積（座標法）計算書 * * *

测点名	夾 角	方向角	距 離	[1]	[2]	[3]	[2]*[3]
				X(i)	Y(i)	X(i+1)-X(i-1)	
14-K1F	90-00-20	185-59-24	20.249	89346.620	-7569.388	-18.938	143349.069944
14-K14	90-07-46	96-07-10	0.516	89326.482	-7571.501	-20.193	152891.319693
14-K15	179-52-00	95-59-10	10.989	89326.427	-7570.988	-1.201	9092.756588
14-K16	90-01-03	6-00-13	20.250	89325.281	-7560.059	18.993	-143588.200587
14-K2F	89-58-51	275-59-04	11.510	89345.420	-7557.941	21.339	-161278.902999
						倍面積	466.042639
						面 積	233.02
						坪 数	70.48

PAGE : 2

* * * 面積 (座標法) 計算書 * * *

[illegible]

*** 面積（座標法）計算書 ***

测点名	夾角	方向角	距離	[1]	[2]	[3]	[2]*[3]
				X(i)	Y(i)	X(i+1)-X(i-1)	
14-K3	89-59-35	185-58-52	20.259	89344.220	-7546.503	-18.949	142998.685347
14-K18	89-38-18	95-37-10	0.500	89324.071	-7548.614	-20.198	152466.905572
14-K19	180-18-58	95-56-08	11.005	89324.022	-7548.116	-1.187	8959.613692
14-K20	90-02-17	5-58-25	20.246	89322.884	-7537.170	18.998	-143191.155660
14-K4F	90-00-52	275-59-17	11.503	89343.020	-7535.063	21.336	-160768.104168
						倍面積	465.944783
						面 積	232.97
						坪 数	70.47

PAGE : 3

* * * 面積（座標法）計算書 * * *

测点名	夾 角	方向角	距 離	[1] X(i)	[2] Y(i)	[3] X(i+1)-X(i-1)	[2]*[3]
14-K4F	89-59-09	185-58-25	20.246	89343.020	-7535.063	-18.937	142691.488031
14-K20	90-12-54	96-11-19	0.501	89322.884	-7537.170	-20.190	152175.462300
14-K21	179-48-38	95-59-57	10.984	89322.830	-7536.672	-1.202	9059.079744
14-K22	89-59-56	5-59-53	20.250	89321.682	-7525.748	18.991	-142921.480268
14-K5F	89-59-23	275-59-16	11.494	89341.821	-7523.632	21.338	-160539.259616
						倍面積	465.290191
						面 積	232.64
						坪 數	70.37

* * * 面積（座標法）計算書 * * *

[illegible]

PAGE : 4

*** 面積 (座標法) 計算書 ***

测点名	夾 角	方向角	距 離	[1]	[2]	[3]	[2]*[3]
				X(i)	Y(i)	X(i+1)-X(i-1)	
14-K6	90-11-27	186-00-10	20.253	89340.622	-7512.196	-19.458	146172.309768
14-K24	88-58-36	94-58-46	0.507	89320.480	-7514.314	-20.186	151683.942404
14-K25	181-01-09	95-59-55	12.114	89320.436	-7513.809	-1.310	9843.089790
D14-9	89-42-34	5-42-29	2.162	89319.170	-7501.761	0.885	-6639.058485
D14-17	179-59-23	5-41-52	1.330	89321.321	-7501.546	3.474	-26060.370804
D14-10	270-35-46	96-17-38	1.505	89322.644	-7501.414	1.158	-8686.637412
D14-11	79-07-13	355-24-51	2.514	89322.479	-7499.918	2.341	-17557.308038
D14-12	180-59-41	356-24-32	6.019	89324.985	-7500.119	8.513	-63848.513047
D14-13	181-23-25	357-47-57	3.854	89330.992	-7500.496	9.858	-73939.889568
D14-14	138-43-06	316-31-03	7.022	89334.843	-7500.644	8.946	-67100.761224
D14-15	139-17-40	275-48-43	6.755	89339.938	-7505.476	5.779	-43374.145804
						倍面積	492.657580
						面 積	246.32
						坪 数	74.51

PAGE : 5

* * * 面積 (座標法) 計算書 * * *

[illegible]

*** 面積 (座標法) 計算書 ***

[illegible]

PAGE : 6

*** 面積 (座標法) 計算書 ***

测点名	夾 角	方向角	距 離	[1]	[2]	[3]	[2]*[3]
				X(i)	Y(i)	X(i+1)-X(i-1)	
14-K21	90-02-04	186-02-01	20.254	89322.830	-7536.672	-18.994	143151.547968
14-K9F	89-56-11	95-58-12	11.499	89302.688	-7538.801	-21.338	160862.935738
14-K8F	90-00-11	5-58-23	20.248	89301.492	-7527.364	18.942	-142583.328888
14-K23	90-04-21	276-02-44	0.494	89321.630	-7525.257	20.190	-151934.938830
14-K22	179-57-13	275-59-57	10.984	89321.682	-7525.748	1.200	-9030.897600
						倍面積	465.318388
						面 積	232.65
						坪 数	70.37

*** 面積 (座標法) 計算書 ***

测点名	夹 角	方向角	距 離	[1]	[2]	[3]	[2]*[3]
				X(i)	Y(i)	X(i+1)-X(i-1)	
14-K19	90-03-34	185-59-42	20.251	89324.022	-7548.116	-19.002	143429.300232
14-K10F	89-58-07	95-57-49	11.492	89303.882	-7550.231	-21.334	161076.628154
14-K9F	90-04-12	6-02-01	20.254	89302.688	-7538.801	18.948	-142845.201348
14-K21	90-09-18	276-11-19	0.501	89322.830	-7536.672	20.196	-152210.627712
14-K20	179-44-49	275-56-08	11.005	89322.884	-7537.170	1.192	-8984.306640
						倍面積	465.792686
						面 積	232.89
						坪 数	70.45

PAGE : 7

*** 面積 (座標法) 計算書 ***

测点名	夹 角	方向角	距 离	[1]	[2]	[3]	[2]*[3]
				X(i)	Y(i)	X(i+1)-X(i-1)	
14-K17	89-55-14	185-56-02	20.256	89325.225	-7559.569	-18.993	143578.894017
14-K11F	90-02-19	95-58-21	11.494	89305.078	-7561.663	-21.343	161388.573409
14-K10F	90-01-21	5-59-42	20.251	89303.882	-7550.231	18.944	-143031.576064
14-K19	89-37-28	275-37-10	0.500	89324.022	-7548.116	20.189	-152388.913924
14-K18	180-23-38	276-00-48	11.016	89324.071	-7548.614	1.203	-9080.982642
						倍面积	465.994796
						面 积	232.99
						坪 数	70.48

* * * 面積 (座標法) 計算書 * * *

测点名称	夹角	方向角	距 离	[1]	[2]	[3]	[2]*[3]
				X(i)	Y(i)	X(i+1)-X(i-1)	
14-K15	90-00-07	185-59-17	20.265	89326.427	-7570.988	-19.008	143909.339904
14-K12F	89-58-33	95-57-50	11.501	89306.273	-7573.102	-21.349	161678.154598
14-K11F	89-58-12	5-56-02	20.256	89305.078	-7561.663	18.952	-143308.637176
14-K17	90-35-09	276-31-11	0.493	89325.225	-7559.569	20.203	-152725.972507
14-K16	179-27-59	275-59-10	10.989	89325.281	-7560.059	1.202	-9087.190918
						倍面积	465.693901
						面 积	232.84
						坪 数	70.43

PAGE : 8

* * * 面積 (座標法) 計算書 * * *

[illegible]