

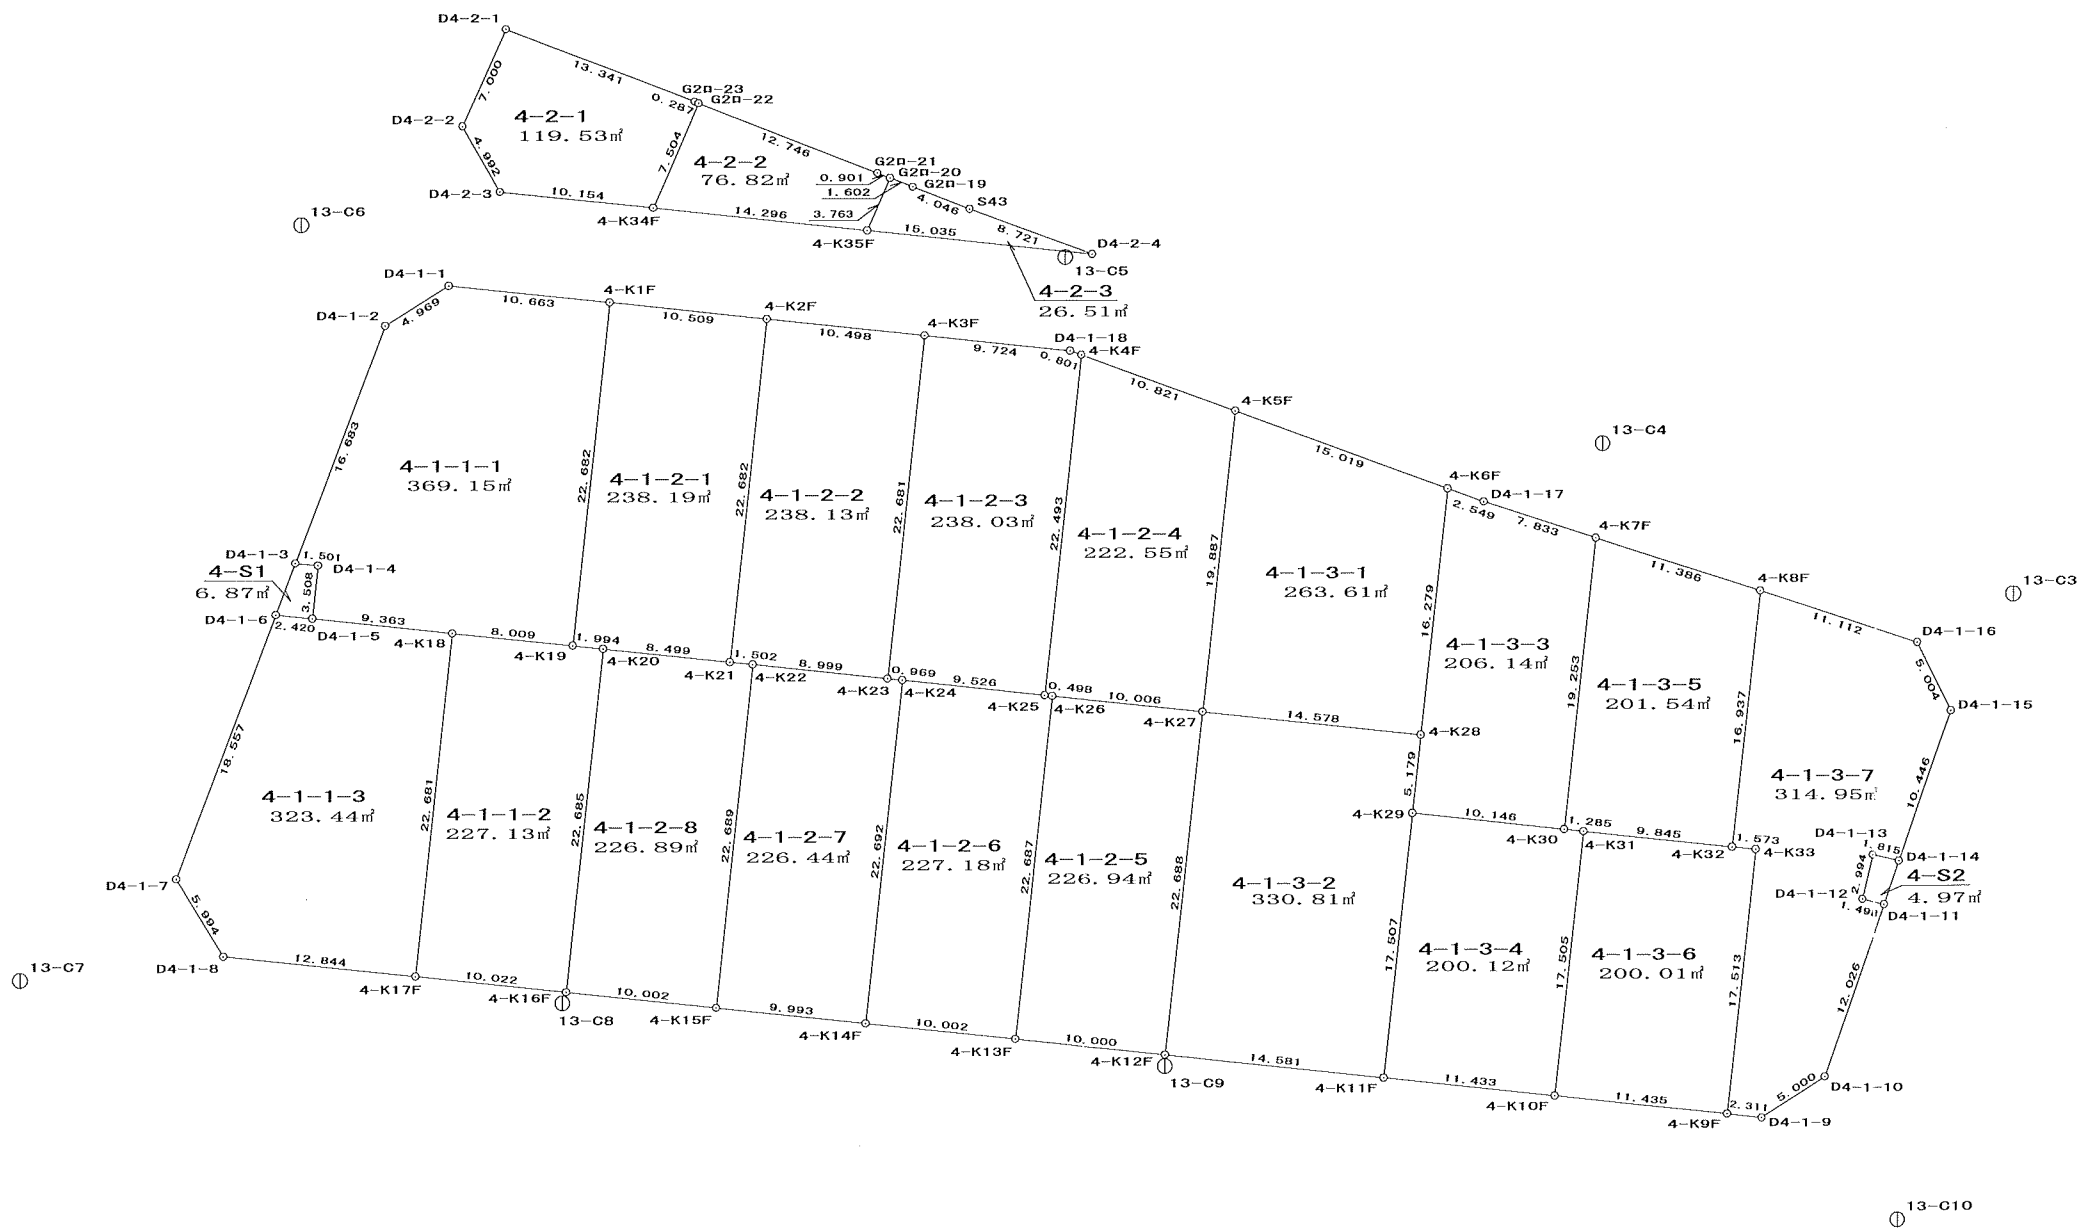


画地出来形確認測量原図

業務委託名	平成14年度 浜田土地区画出来形確認測量業務
-------	------------------------

縮尺	500
----	-----

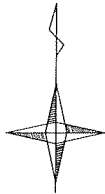

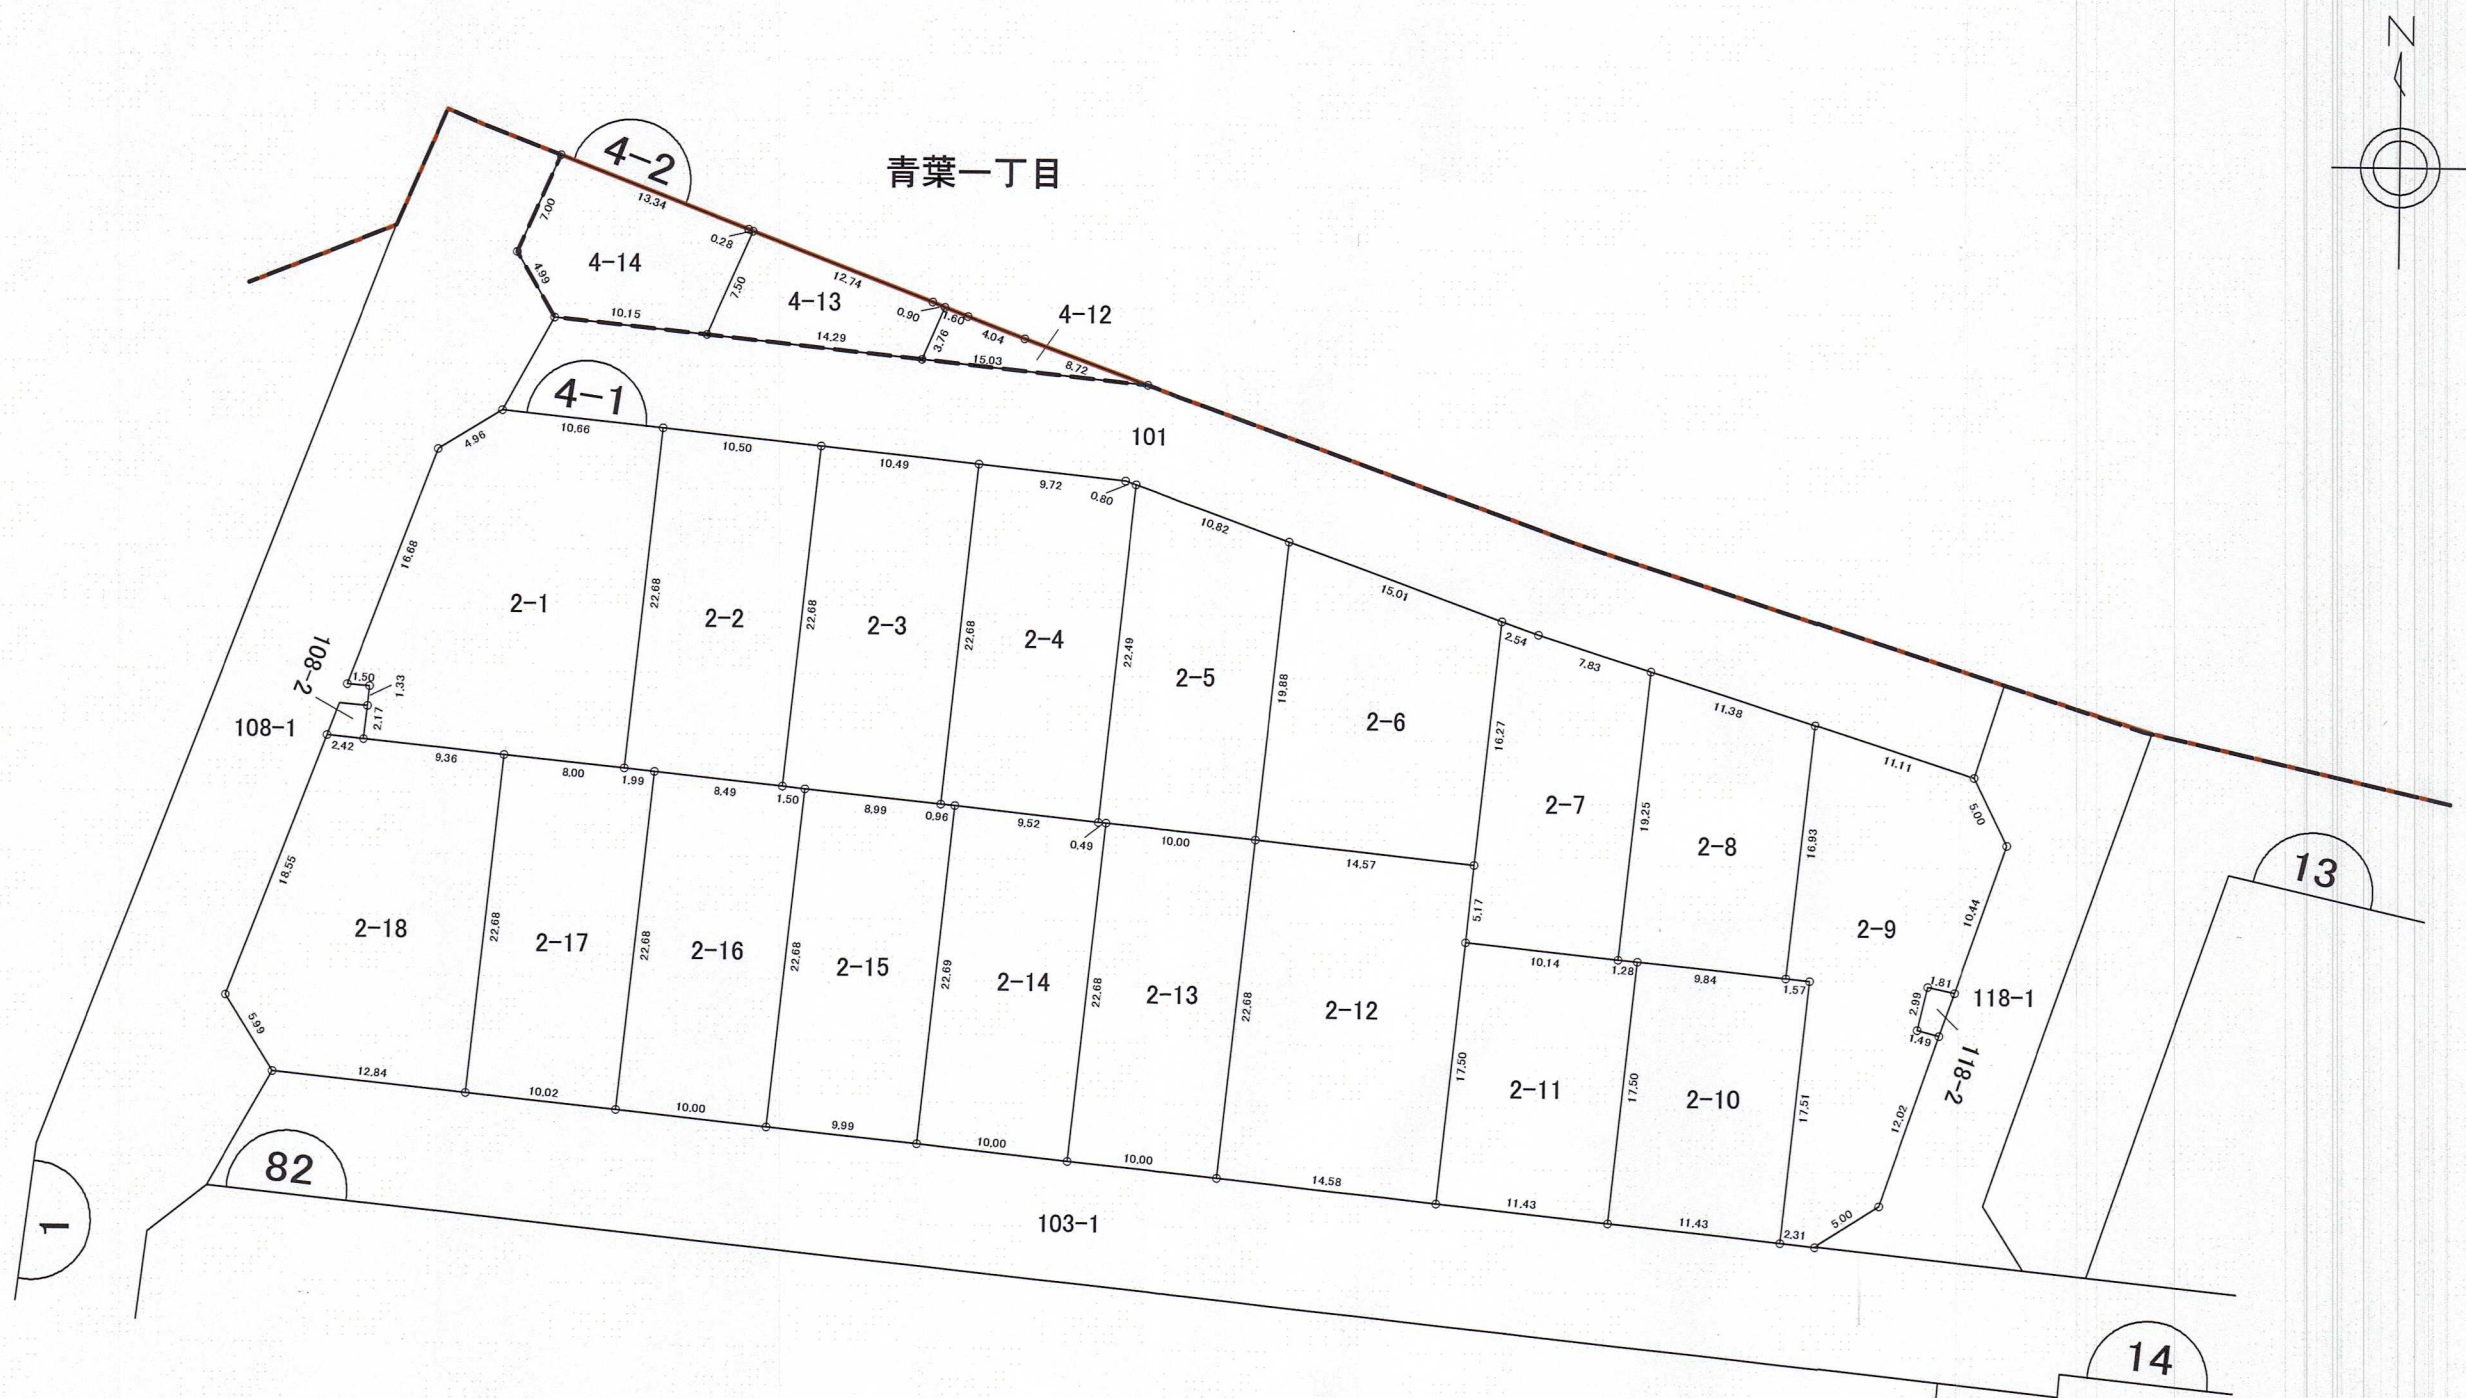

凡 例	
1-1	地 番
---	大 字 界
---	字 界
---	施 行 地 区 界
---	換 地 の 位 置

PAGE : 1

*** 面積 (座標法) 計算書 ***

测点名	夹 角	方向角	距 离	[1]	[2]	[3]	[2]*[3]
				X(i)	Y(i)	X(i+1)-X(i-1)	
D4-1-1	142-08-11	238-06-03	4.969	89410.769	-7684.335	-1.518	11664.820530
D4-1-2	142-39-56	200-45-59	16.683	89408.143	-7688.554	-18.225	140123.896650
D4-1-3	74-55-44	95-41-43	1.501	89392.544	-7694.469	-15.748	121172.497812
D4-1-4	270-23-17	186-05-00	1.330	89392.395	-7692.975	-1.472	11324.059200
D4-1-20	179-58-51	186-03-51	2.177	89391.072	-7693.116	-3.488	26833.588608
D4-1-5	89-57-01	96-00-52	9.363	89388.907	-7693.346	-3.146	24203.266516
4-K18	179-54-20	95-55-12	8.009	89387.926	-7684.035	-1.807	13885.051245
4-K19	89-59-56	5-55-08	22.682	89387.100	-7676.069	21.735	-166839.359715
4-K1F	90-02-44	275-57-52	10.663	89409.661	-7673.730	23.669	-181629.515370
						倍面积	738.305476
						面 积	369.15
						坪 数	111.66

*** 面積（座標法）計算書 ***

[illegible]

PAGE : 2

東大野一丁目2-18

***** 面積 (座標法) 計算書 *****

地番 = 4-1-1-3

测点名	夹 角	方向角	距 離	[1]	[2]	[3]	[2]*[3]
				X(i)	Y(i)	X(i+1)-X(i-1)	
D4-1-6	104-57-08	200-47-16	18.557	89389.153	-7695.753	-17.103	131620.463559
D4-1-7	127-29-51	148-17-07	5.994	89371.804	-7702.339	-22.448	172902.105872
D4-1-8	127-40-52	95-57-59	12.844	89366.705	-7699.188	-6.434	49536.575592
4-K17F	90-03-16	6-01-15	22.681	89365.370	-7686.414	21.221	-163113.391494
4-K18	89-59-37	276-00-52	9.363	89387.926	-7684.035	23.537	-180859.131795
D4-1-5	179-49-16	275-50-08	2.420	89388.907	-7693.346	1.227	-9439.735542
						倍面積	646.886192
						面 積	323.44
						坪 数	97.84

東大野一丁目2-2

* * * 面積 (座標法) 計算書 * * *

地番 = 4-1-2-1

测点名	夾 角	方向角	距 離	[1]	[2]	[3]	[2]*[3]
				X(i)	Y(i)	X(i+1)-X(i-1)	
4-K1F	89-57-16	185-55-08	22.682	89409.661	-7673.730	-21.469	164747.309370
4-K19	90-07-34	96-02-42	1.994	89387.100	-7676.069	-22.771	174791.767199
4-K20	179-53-54	95-56-36	8.499	89386.890	-7674.086	-1.090	8364.753740
4-K21	90-00-59	5-57-35	22.682	89386.010	-7665.633	21.679	-166183.257807
4-K2F	90-00-17	275-57-52	10.509	89408.569	-7663.278	23.651	-181244.187978
						倍面積	476.384524
						面 積	238.19
						坪 数	72.05

PAGE : 3

*** * * 面積 (座標法) 計算書 * * ***

测点名	夾 角	方向角	距 離	[1]	[2]	[3]	[2]*[3]
				X(i)	Y(i)	X(i+1)-X(i-1)	
4-K2F	89-59-40	185-57-35	22.682	89408.569	-7663.278	-21.468	164515.252104
4-K21	89-57-48	95-55-23	1.502	89386.010	-7665.633	-22.714	174117.187962
4-K22	180-02-50	95-58-13	8.999	89385.855	-7664.139	-1.091	8361.575649
4-K23	89-58-55	5-57-08	22.681	89384.919	-7655.189	21.623	-165528.151747
4-K3F	90-00-47	275-57-55	10.498	89407.478	-7652.837	23.650	-180989.595050
						倍面積	476.268918
						面 積	238.13
						坪 数	72.03

*** * * 面積 (座標法) 計算書 * * ***

测点名	夾 角	方向角	距 離	[1]	[2]	[3]	[2]*[3]
				X(i)	Y(i)	X(i+1)-X(i-1)	
4-K3F	89-59-03	185-57-08	22.681	89407.478	-7652.837	-21.548	164903.331676
4-K23	89-47-37	95-44-45	0.969	89384.919	-7655.189	-22.656	173435.961984
4-K24	180-16-03	96-00-48	9.526	89384.822	-7654.225	-1.095	8381.376375
4-K25	89-57-11	5-57-59	22.493	89383.824	-7644.751	21.373	-163391.263123
4-K4F	103-53-40	289-51-39	0.801	89406.195	-7642.413	22.643	-173047.157559
D4-1-18	166-06-26	275-58-05	9.724	89406.467	-7643.166	1.283	-9806.181978
						倍面積	476.067375
						面 積	238.03
						坪 数	72.00

PAGE : 4

*** 面積（座標法）計算書 ***

[illegible]

*** 面積（座標法）計算書 ***

[illegible]

PAGE : 5

* * * 面積 (座標法) 計算書 * * *

测点名	夾 角	方向角	距 離	[1]	[2]	[3]	[2]*[3]
				X(i)	Y(i)	X(i+1)-X(i-1)	
4-K24	89-53-25	185-54-13	22.692	89384.822	-7654.225	-21.574	165132.250150
4-K14F	90-03-53	95-58-06	10.002	89362.250	-7656.559	-23.612	180786.671108
4-K13F	89-59-24	5-57-30	22.687	89361.210	-7646.611	21.524	-164585.655164
4-K26	89-48-34	275-46-04	0.498	89383.774	-7644.256	22.614	-172867.205184
4-K25	180-14-44	276-00-48	9.526	89383.824	-7644.751	1.048	-8011.699048
						倍面積	454.361862
						面 積	227.18
						坪 数	68.72

* * * 面積 (座標法) 計算書 * * *

测点名	夾 角	方向角	距 離	[1]	[2]	[3]	[2]*[3]
				X(i)	Y(i)	X(i+1)-X(i-1)	
4-K22	89-59-51	185-58-04	22.689	89385.855	-7664.139	-21.630	165775.326570
4-K15F	90-00-00	95-58-04	9.993	89363.289	-7666.498	-23.605	180967.685290
4-K14F	89-56-09	5-54-13	22.692	89362.250	-7656.559	21.533	-164868.684947
4-K24	89-50-32	275-44-45	0.969	89384.822	-7654.225	22.669	-173513.626525
4-K23	180-13-28	275-58-13	8.999	89384.919	-7655.189	1.033	-7907.810237
						倍面積	452.890151
						面 積	226.44
						坪 数	68.49

PAGE : 6

*** 面積 (座標法) 計算書 ***

[illegible]

* * * 面積 (座標法) 計算書 * * *

测点名	夹 角	方向角	距 離	[1] X(i)	[2] Y(i)	[3] X(i+1)-X(i-1)	[2]*[3]
4-K5F	76-05-26	185-57-58	19.887	89402.515	-7632.237	-14.673	111987.813501
4-K27	90-00-39	95-58-37	14.578	89382.736	-7634.304	-21.297	162587.772288
4-K28	89-59-20	5-57-57	16.279	89381.218	-7619.805	14.673	-111805.398765
4-K6F	103-54-35	289-52-32	15.019	89397.409	-7618.113	21.297	-162242.952561
						倍面積	527.234463
						面 積	263.61
						坪 数	79.74

PAGE : 7

* * * 面積 (座標法) 計算書 * * *

[illegible]

*** 面積 (座標法) 計算書 ***

测点名	夹 角	方向角	距 离	[1] X(i)	[2] Y(i)	[3] X(i+1)-X(i-1)	[2]*[3]
4-K6F	76-04-50	185-57-57	16.279	89397.409	-7618.113	-15.324	116739.963612
4-K28	179-57-10	185-55-07	5.179	89381.218	-7619.805	-21.342	162621.878310
4-K29	90-03-40	95-58-47	10.146	89376.067	-7620.339	-6.208	47307.064512
4-K30	89-57-54	5-56-41	19.253	89375.010	-7610.248	18.092	-137684.606816
4-K7F	101-45-58	287-42-39	7.833	89394.159	-7608.254	21.532	-163820.925128
D4-1-17	182-10-28	289-53-07	2.549	89396.542	-7615.716	3.250	-24751.077000
						倍面積	412.297490
						面 積	206.14
						坪 数	62.35

PAGE : 8

*** 面積 (座標法) 計算書 ***

测点名	夾 角	方向角	距 離	[1]	[2]	[3]	[2]*[3]
				X(i)	Y(i)	X(i+1)-X(i-1)	
4-K29	90-00-02	185-58-49	17.507	89376.067	-7620.339	-16.355	124630.644345
4-K11F	89-59-03	95-57-52	11.433	89358.655	-7622.163	-18.600	141772.231800
4-K10F	90-00-36	5-58-28	17.505	89357.467	-7610.792	16.222	-123462.267824
4-K31	89-58-01	275-56-29	1.285	89374.877	-7608.970	17.543	-133484.160710
4-K30	180-02-18	275-58-47	10.146	89375.010	-7610.248	1.190	-9056.195120
						倍面積	400.252491
						面 積	200.12
						坪 数	60.53

*** 面積（座標法） 計算書 ***

[illegible]

PAGE : 9

* * * 面積 (座標法) 計算書 * * *

测点名	夹 角	方向角	距 離	[1]	[2]	[3]	[2]*[3]
				X(i)	Y(i)	X(i+1)-X(i-1)	
4-K31	89-59-32	185-58-28	17.505	89374.877	-7608.970	-16.384	124665.364480
4-K10F	89-59-38	95-58-06	11.435	89357.467	-7610.792	-18.599	141553.120408
4-K9F	89-57-02	5-55-08	17.513	89356.278	-7599.419	16.231	-123346.169789
4-K33	89-39-41	275-34-49	1.573	89373.698	-7597.613	17.573	-133512.853249
4-K32	180-24-07	275-58-56	9.845	89373.851	-7599.179	1.179	-8959.432041
						倍面積	400.029809
						面 積	200.01
						坪 数	60.50

PAGE : 10

*** 面積 (座標法) 計算書 ***

[illegible]